


Section 12 Township 14 Range 17 W

Well No. # 1 Lang

Company Franco-Central

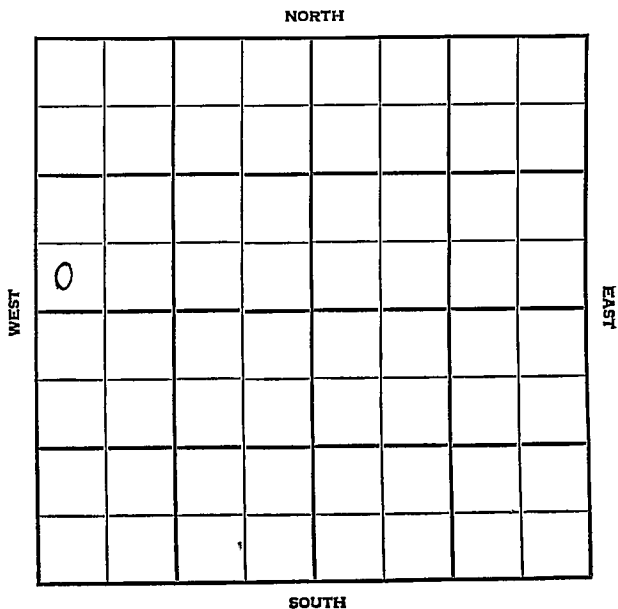

SEC. 12	TWP. 14	R. 17W
------------	------------	-----------

WELL NO. #1 Lang FARM

COMPANY

FRANCO-CENTRAL

CONTRACTOR Lewis Drlg.


Toulon Pool

_____ Ft. from N. Line

330 _____ Ft. from S. Line

_____ Ft. from E. Line

330 _____ Ft. from W. Line

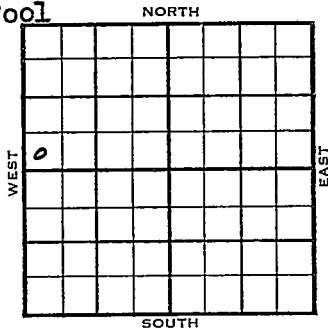

SW SW NW
Derb y DHM

1954	ELEVATION 1948' DF	REPORT
------	-----------------------	--------

9/15 Location

9/29 Spud 9-16-54
D & A
TD 3607'
8" @234'
Anhy 1115', Lans 3238', Top 2939'
Heeb 3192', Tor 3211', Arb 3592'
TD 3607'
D & A

ABANDONED

County Ellis State Kansas

Sec. 12 (^{Blk.}_{Twp.}) 14 (^{Sur.}_{Rge.}) 17W Map No.

Operator Franco-Central

Well No. 1 Farm Lang

Elev. 1948 DF Location SW SW NW

330 Ft. From S Line NW

330 Ft. From W Line Quarter

Ist. Report Sep 15 1954

Completion SEP 29 1954

Remarks Skelly & Amer. DHM Derby DHM

Lewis Drlg. Tools

Spudding Date 9/16/54

Drlg. Data D & A TD 3607 Toulon Pool

8" @ 234 Anhy 1115 Lans. 3238

Top. 2939 Heeb. 3192 Tor. 3211

Arb. 3592 TD 3607

D & A

FABEN GILSTRAP