

Ellis

KANSAS


DX 78-1

Section 9 Township 14 Range 17W

Well No. #1 Lang

Company Leben Oil

NORTH

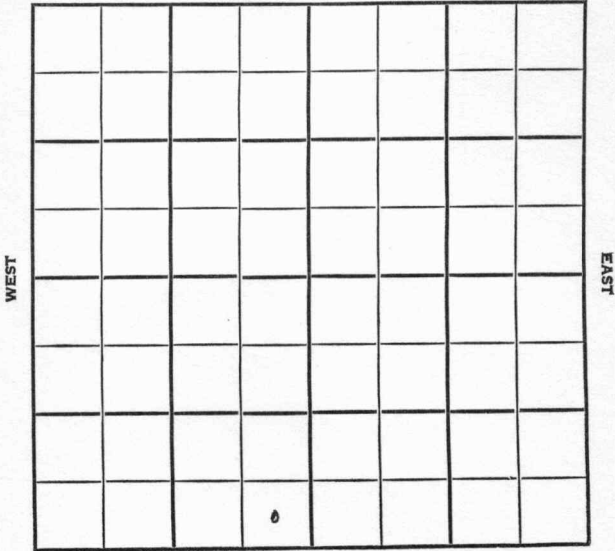

SOUTH

Ellis KANSAS


SEC.	TWP.	R.
9	14	17W

WELL NO. 1 Lang FARM

COMPANY Leben Oil

CONTRACTOR Co. Tools

_____ Ft. from N. Line
 330 _____ Ft. from S. Line
 330 _____ Ft. from E. Line
 _____ Ft. from W. Line

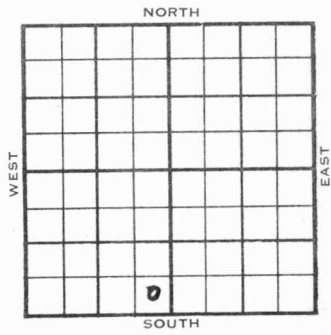

SE SE SW

Sun Farmout.

	ELEVATION	REPORT
1955	22002'	

1/19 Cellar & Pits
 2/2 Spud 1-19-55
 D & A
 TD 3617'
 8" @ 150'
 Anhy 1180' Lans 3281' Cong 3524'
 DST 3508'-38' opn 1/2 hr, rec 4' Mud
 Arb. 3530'
 DST 3542'-73' opn 1/2 hr, rec 8' Mud 175'
 TD 3617'
 D & A

ABANDONED

