


Ellis

Map No. _____ Sec. 10 Twp. 14 R. 17^W

Well No. 1 - Sanders Farm _____
Gwin Dlg Company _____

330 Ft. from N. Line
____ Ft. from S. Line
330 Ft. from E. Line
____ Ft. from W. Line
Elev. 2006

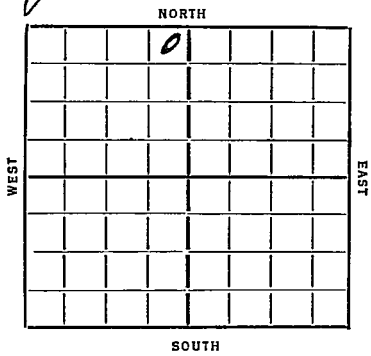

REPORT

DATE	REPORT
1/15	
1/15	Rig
1/24	Rig
1/31	Dlg 1570 12" 57
2/7	" 1725
2/14	" 2800
2/21	10" 835 TD 3280 hung 7"
2/28	7" 3280 Dev. 3298
	5 Barrels Oil per hr 3341-25TD
	SD for 5" pipe
3/6	HFW 3332 5" 3332
	Dlg 3385
3/13	Sho Oil 3388-94 TD
	WR 5"
3/20	5"-3362 Show oil 3515-20 Drlg. 3553
3/27	T. Sil. 3545' T.D. 3570' U.R. 5"
4/2	5"-3545' Drlg. plug.
4/8	Water 3600-26 TD
	NTA.

ABANDONED

Map No. 71 Sec. 10 Twp. 14 R. 17W

Well No. 1 - Sanders

Twin Drly Company

Contractor

FIRST REPORTS

SECTION PLAT

330 Ft. from N. Line

..... Ft. from S. Line

330 Ft. from E. Line

..... Ft. from W. Line

	0		

Location.....

Rig up.....

Drilling and Remarks:

Rig

RECORD

Cased.....in.,ft.

Sand.....

Gas.....

Oil.....

Total Depth.....

PRODUCTION

1st 24 hrs. Nat.....

1st 24 hrs. after shot.....

Gas.....Cu. Ft.

Dry Hole.....

Abandoned.....

Date

1-15-36 192..... JRVAL MANNSCHRECK Scout

KANSAS

Map No. 71 Sec. 10 Twp. 14 R. 12W

Well No. 1 Sanders

Twin Mill Company

Contractor

SECTION PLAT

	0		

330 Ft. from N. Line

..... Ft. from S. Line

330 Ft. from E. Line

..... Ft. from W. Line

ABANDONED

Location.....

Rig up.....

Drilling and Remarks:

Water 3600 -26

JJA

RECORD

Cased..... in., ft.

Sand.....

Gas.....

Oil.....

Total Depth... 3626

PRODUCTION

1st 24 hrs. Nat.....

1st 24 hrs. after shot.....

Gas..... Cu. Ft.

Dry Hole.....

Abandoned.....

Date

7/8/36 192.....

S. J. LEWIS

Scout