

Sawley

Form 252A-5M-5-28-Mid-West

Map No. **KANSAS** Sec. 17 Twp. 34 R. 3E

Well No. 1-Beard Farm


Shawver et al Company

..... Ft. from N. Line

330 Ft. from S. Line

990 Ft. from E. Line

..... Ft. from W. Line

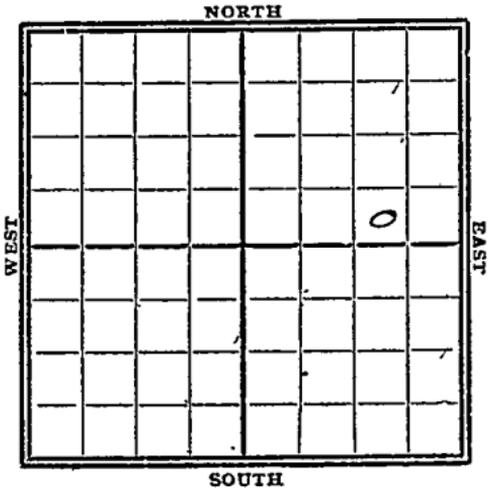

1928

Date	REPORT
10/31	Roly.
11/7	—
11/14	Rig Bldg
11/21	Rig
11/28	Rigging up
12/5	—
12/12	Spud
12/19	drlg 620'
12/26	" 987'
1929	
1/2	" 2000'
1/9	S.D. 2000' T.D.
1/16	—
1/23	—
1/30	—
2/6	—
2/13	drlg 2240'-HFW
2/20	" 2430'
2/27	show oil 2664-67
	drlg 2670'
3/6	" 2710'
3/13	" 3097' 6"-3072'

3/20 Burbank sd. 3340-50'
4 1/2 M gas

3/27 Burbank 3340-58'
T.D. 3358'
6 M gas
Comp.

1930
4/2-

OWDD

Old TD. 3358
Base sand 3380
400' oil in hole
Top chat 3412-14
HFW
P.B. to 3380'

4/9 - Shot 20 gts. 3365-70
Slg. out.

4/16 - Base sand 3380
Chat 3412-14' HFW
P.B. to 3380.
Shot 20 qt 3365-70
10 bbl oil
Comp.

K1 Country
 MAP No. WESGAS SEC. 17 TWP. 34 R. 3E

WELL No. 1 Beard

Shawver & Co COMPANY

CONTRACTOR

SECTION PLAT

			0

_____ FT. FROM N. LINE

330 FT. FROM S. LINE

990 FT. FROM E. LINE

_____ FT. FROM W. LINE

FIRST REPORTS

LOCATION _____

RIG UP _____

DRILLING AND REMARKS:
R.O.G

RECORD

CASED _____ IN. _____ FT.

SAND _____

GAS _____

OIL _____

TOTAL DEPTH _____

PRODUCTION

1ST 24 HRS. NAT. _____

1ST 24 HRS. AFTER SHOT _____

GAS _____ CU. FT.

DRY HOLE _____

ABANDONED _____

DATE

OCT 31 1928 192 .

S. J. LEWIS

SCOUT

Cowley
 Map No. **KANSAS** Sec. *17* Twp. *34* R. *3E*

Well No. *1 Beard*

Shawver & Dal Company

Contractor

SECTION PLAT

..... Ft. from N. Line

330 Ft. from S. Line

990 Ft. from E. Line

..... Ft. from W. Line

COMPLETED

			0

Location.....

Rig up.....

Drilling and Remarks:

Burdan Sand

3340 & 3308

6M Gas

RECORD

Cased..... in., ft.

Sand.....

Gas.....

Oil.....

Total Depth *3358*

PRODUCTION

1st 24 hrs. Nat.....

1st 24 hrs. after shot.....

Gas..... Cu. Ft.

✓ Dry Hole.....

Abandoned.....

Date

MAR 27 1929

..... 192.....

S. J. LEWIS Scout

Cowley

Map No. **KANSAS** Sec. *17* Twp. *34* R. *3*^E

Well No. *1* *Baird*

Shawver et al Company

Contractor

FIRST REPORTS

SECTION PLAT

..... Ft. from N. Line

330 Ft. from S. Line

990 Ft. from E. Line

..... Ft. from W. Line

"old well deeper"

Location.....

Rig up.....

Drilling and Remarks:

JD was 3358

Base Sand 3380'
400' below here.

top chat 3412-3414

new. PBT to 3380'

RECORD

Cased..... in., ft.

Sand.....

Gas.....

Oil.....

Total Depth.....

PRODUCTION

1st 24 hrs. Nat.....

1st 24 hrs. after shot.....

Gas..... Cu. Ft.

Dry Hole.....

Abandoned.....

Date

APR 2 1930

CHAS. L. SHERWOOD

192..... Scout

700

Sam

Sam, I guess this is #1, as I can't find our old ticket.

[Large handwritten scribble]

Returned
Cards <i>CH</i>
Tracing <i>CH</i>
France Map
Scarborough Map <i>CH</i>
Moody Map <i>X</i>
Scarborough Plat Book
Moody Plat Book

Cowley

Map No. **KANSAS** Sec. **17** Twp. **34** R. **3^E**

Well No. **1 Baird**

Shawver et al Company

Contractor

COMPLETE

SECTION PLAT

.....Ft. from N. Line

330 Ft. from S. Line

990 Ft. from E. Line

.....Ft. from W. Line

			0

Location.....

Rig up.....

Drilling and Remarks:

Base Sand 3380'
Chat 3412-3414' HW,
9B to 3380'
Shot 20/3365-70'
10 Bks.

RECORD

Cased.....in.,ft.
 Sand.....
 Gas.....
 Oil.....
 Total Depth.....

PRODUCTION

1st 24 hrs. Nat.....
 1st 24 hrs. after shot.....
 Gas.....Cu. Ft.
 Dry Hole.....
 Abandoned.....

Date

APR 16 1900

192.....

CHAS. L. SHERWOOD

Scout