

Section 17 Township 34S Range 3E

Well No. 2 Baird

Company Stelbar Oil Corp.

NORTH

							1

WEST

EAST

SOUTH

0

Cowley

KANSAS

SEC. 17-	TWP. 34S	R. 3E
-------------	-------------	----------

WELL NO. #2 Baird FARM

COMPANY

Stelbar Oil Corp.

CONTRACTOR


Baird

\_\_\_\_\_ Ft. from N. Line

\_\_\_\_\_ Ft. from S. Line

\_\_\_\_\_ Ft. from E. Line

\_\_\_\_\_ Ft. from W. Line

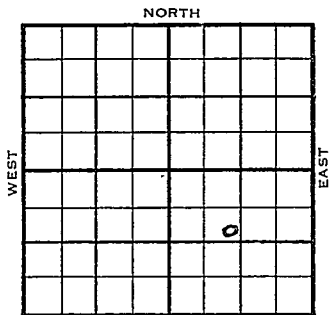

SE NW SE

FIRST REPORT

1955	ELEVATION	REPORT
	1161'	
7/13	Spud 7/7/55	
	8" 102 w/100	D 2020
8/10	5 1/2" @3396 CO to	3400 frac S/6 boph,
	S/10 bo 28 bwph	Comp. 25 bopd 25 bw.
	KC.	2872 1711
	<del>KC</del> .Bart	3348 2187
	M.	3396 2235
	TD.	3400

COMPLETED

County Cowley Elev. \_\_\_\_\_  
 Sec. 17 Twp. 31S Rge. 3E  
 Company Stelbar Oil Corp.  
 FarmName Baird No. 2

TOPS	DEPTH	LOG	DATUM
Anh.			
Tp.			
H.			
Tr.			
Dg.			
Bl.			
L.			
K.C.			
B.K.C.			
Ce.			
C.			
M.			
M.			
K.			
Mz.			
Me.			
V.			
S.			
S.			
A.			
R.			
PE.			
G.			
T.D.			

Loc. in Sec. \_\_\_\_\_  
SE NW SE  
1000' SL  
1100' WL  
 Geol. \_\_\_\_\_  
 Contr. \_\_\_\_\_  
 Pool Baird

FIRST REPORT  
 JUL 13 '55

Date Comm. spc 7/7/55 8" 102 w/100 D2020

Co. Lse. No. Sec. T. R.

