


Cowley

SECTION 17 TOWNSHIP 34 RANGE 3E

WELL NO. #3 Baird

COMPANY Stelbar

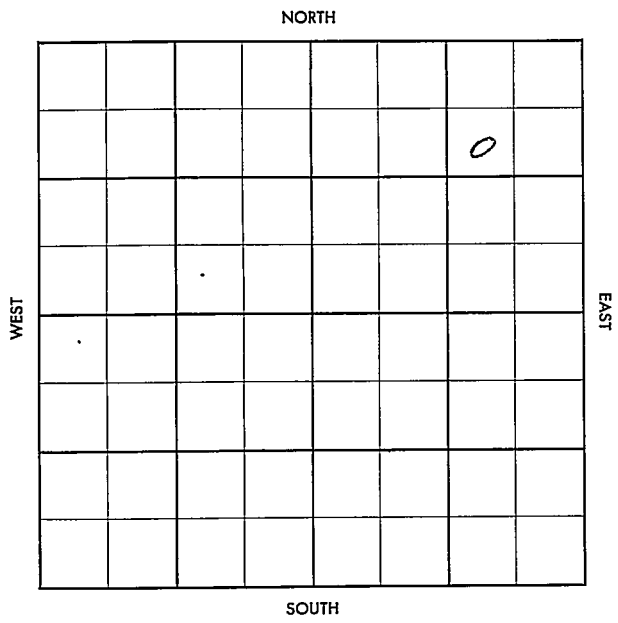

Cowley

KANSAS

SEC. 17	TWP. 34	R. 3E
------------	------------	----------

WELL NO. #3 Baird FARM

COMPANY Stelbar

CONTRACTOR Prairie

Gueda Springs


_____ Ft. from N. Line

_____ Ft. from S. Line

_____ Ft. from E. Line

_____ Ft. from W. Line

X SW NE NE

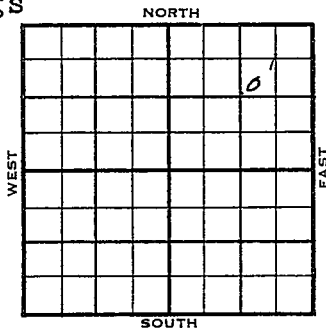

1956

ELEVATION

1134

REPORT

5-9

Comm. 5-6-56
8" @ 125
Drlg. 752

5-23

D&A
Lay Sd. 2661', KG. 2833', Bartl Zn.
3329', Bartl Sd. 3350', M. 3385'
TD 3398'

ABANDONED

County Cowley Elev. _____
 Sec. 17 Twp. 34 Rge. 3E
 Company Stolbar
 FarmName Baird No. 3

TOPS	DEPTH	LOG	DATUM
Anh.			
Tp.			
H.			
Tr.			
Dg.			
Bl.			
L.			
K.C.			
B.K.C.			
Ce.			
C.			
M.			
M.			
K.			
Mz.			
Mq.			
V.			
S.			
S.			
A.			
R.			
Pe.			
G.			
T.D.			

Loc. in Sec. SW NE NE
 Geol. _____
 Contr. Prairie
 Pool Gueda Springs

FIRST REPORT
 MAY 9 1956

Date Comm. 5-6-56
8" @ 125' drl. 752

MAY 14 1956

Handwritten signature

Co.
Lse.
No.
Sec.
T.
R.

County Cowley Elev. 1134
 Sec. 17 Top. 34 Rge. 3E
 Company Stelbar
 Farm Name Baird No. 3

TOPS	DEPTH	LOG	DATUM
Anh.			
Tp. <u>Lay sd</u>	<u>2661</u>		
H.			
Tr.			
Dg.			
Bl.			
L.			
K.C.	<u>2833</u>		
B.K.C. <u>Bart/zn</u>	<u>3329</u>		
Gr. <u>" sd</u>	<u>3350</u>		
C.			
M.	<u>3385</u>		
M.			
K.			
Mz.			
Mo.			
V.			
S.			
S.			
A.			
R.			
PE.			
G.			
FD. ?	<u>3398</u>		

Loc. in Sec. SW NE NE
1100 NL
1050 EL
 Geol. _____
 Contr. _____
Prairie
 Pool _____
Gueda Springs



ABANDONED

Date Comm. 5-6-56 MAY 23 1956
8" @ 125 drlg. 752 MAY 16 '56 MAY 23 '56

D&A