


Sowley

Map No. KANSAS Sec. 17 Twp. 34 R. 3E

Well No. #5-Beard Farm _____
Shawver et al Company

_____ Ft. from N. Line
990 Ft. from S. Line
330
~~990~~ Ft. from E. Line
 _____ Ft. from W. Line

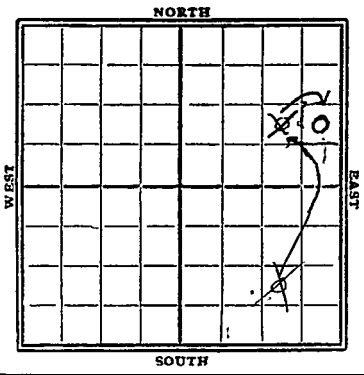

1929

Date	REPORT
3/27	Location
4/13	—
4/10	—
4/17	—
4/24	—
5/11	—
5/18	—
5/15	—
5/22	—
5/29	—
6/5	—
6/12	—
6/19	Spud
6/26	" 230'
7/2	Drily 1040'
7/10	" 1550'
7/17	" 1950' HFW 1925
7/24	VIC 8" - 2200'
7/31	—
8/7	SD. 2625'
8/14	Drily 2900'
8/21	" 2900'

8/28 - Well 3328

9/4 - sand 3322-43'

TD 3343'

5 1/4" A gas
Comp.

Map No. Cowley **KANSAS** Sec. 17 Twp. 34 R. 3E

Well No. 2. Beard

Shawver & Co Company

Contractor

SECTION PLAT

			o

..... Ft. from N. Line

990 Ft. from S. Line

990 Ft. from E. Line

..... Ft. from W. Line

FIRST REPORTS

Location

Rig up

Drilling and Remarks:

RECORD

Cased.....in.,ft.

Sand.....

Gas.....

Oil.....

Total Depth.....

PRODUCTION

1st 24 hrs. Nat.....

1st 24 hrs. after shot.....

Gas.....Cu. Ft.

Dry Hole.....

Abandoned.....

Date

MAR 27 1920

S. J. LEWIS Scout

Cowley
 Map No. KANSAS Sec. 17 Twp. 24 R. 3E
 Well No. 5 Beard

Shawnee & Co. Company
 Contractor

SECTION PLAT

..... Ft. from N. Line
990 Ft. from S. Line
990 Ft. from E. Line
 Ft. from W. Line

			0

CORRECTION

Location.....

Rig up.....

Drilling and Remarks:

*Rejected as No. 2
 in No. 8888*

RECORD

Cased..... in., ft.
 Sand.....
 Gas.....
 Oil.....
 Total Depth.....

PRODUCTION

1st 24 hrs. Nat.....
 1st 24 hrs. after shot.....
 Gas..... Cu. Ft.
 Dry Hole.....
 Abandoned.....

Date

APR 10 1929

S. J. LEWIS Scout

Cowley

Map No. **KANSAS** Sec. *17* Twp. *34* R. *3 E*

Well No. *5 Beard*

Shawver et al Company

Contractor

SECTION PLAT

CORRECTION

..... Ft. from N. Line

990 Ft. from S. Line

330 Ft. from E. Line

..... Ft. from W. Line

			<i>29</i>

Location.....

Rig up.....

Drilling and Remarks:

Chy location

RECORD

Cased.....in.,ft.

Sand.....

Gas.....

Oil.....

Total Depth.....

PRODUCTION

1st 24 hrs. Nat.....

1st 24 hrs. after shot.....

Gas.....Cu. Ft.

Dry Hole.....

Abandoned.....

Date

7/24/29

192.....

CHAS. L. SHERWOOD

Scout

Rowley

 Map No. KANSAS Sec. 17 Twp. 34 R. 3
Well No. 5 Beard

Shawver et al Company

Contractor

COMPLETE

SECTION PLAT

_____ Ft. from N. Line

990 Ft. from S. Line330 Ft. from E. Line

_____ Ft. from W. Line

			0

Location _____

Rig up _____

Drilling and Remarks:

Gas well.

RECORD

Cased _____ in., _____ ft.

Sand 3322-3343

Gas _____

Oil _____

Total Depth 3343

PRODUCTION

1st 24 hrs. Nat. _____

1st 24 hrs. after shot _____

Gas 5 1/4 M Cu. Ft.

Dry Hole _____

Abandoned _____

Date
SEP 4 1929

CHAS. L. SHERWOOD