


Map No. KANSAS Sec. 17 Twp. 34 R. 3E

Well No. 6 - Baird Farm _____
Shawver et al Company

NORTH

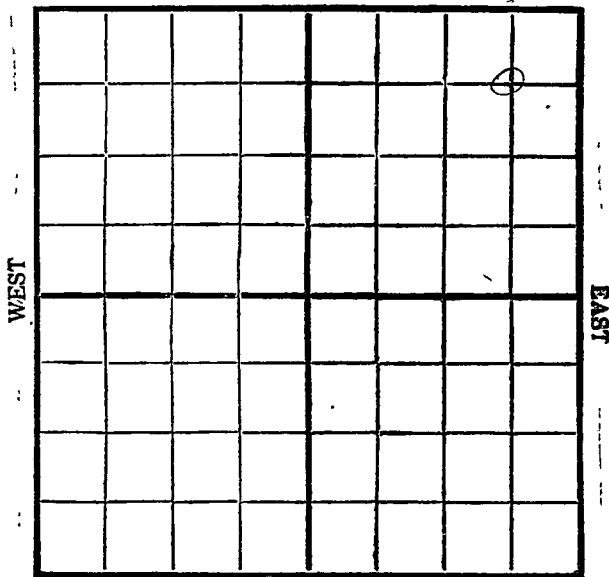

SOUTH

Location _____

Drilling Remarks _____

Rig Up _____

Drilling Remarks _____

RECORD

Cased _____ in. _____ ft.

Sand _____

Gas _____

Oil _____

Total Depth _____

PRODUCTION

1st 24 hrs. Nat. _____

1st 24 hrs. after shot _____

Gas _____ cu. ft.

Dry Hole _____

Abandoned _____

Sawley

FORM 252A-5M-12-28-PETROL

Map No. KANSAS Sec. 17 Twp. 34 R. 3E

Well No. 6- Baird Farm


Shawver et al Company

660 Ft. from N. Line

_____ Ft. from S. Line

660 Ft. from E. Line

_____ Ft. from W. Line

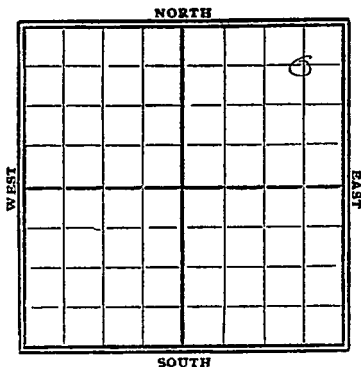

1929

Date	REPORT
7/17	Machine
7/24	—
7/31	—
8/7	SD 230'
8/14	Wdry 445'
8/21	—
8/28	dry 1680
9/4	SD 1820' for csg
9/11	—
9/18	—
9/25	—
10/2	—
10/9	—
10/16	—
10/23	—
10/30	—
11/6	—
11/13	FD. 1963' dry & abandon

Cowley

Map No. **KANSAS** Sec. 17 Twp. 34 R. 3^E

Well No. 6 Baird
Shawver & Co Company

Contractor

FIRST REPORTS

SECTION PLAT

660 Ft. from N. Line
 _____ Ft. from S. Line
660 Ft. from E. Line
 _____ Ft. from W. Line

			⊙

Location _____
 Rig up Machine
 Drilling and Remarks:

RECORD

Cased _____ in., _____ ft.
 Sand _____
 Gas _____
 Oil _____
 Total Depth _____

PRODUCTION

1st 24 hrs. Nat. _____
 1st 24 hrs. after shot _____
 Gas _____ Cu. Ft.
 Dry Hole _____
 Abandoned _____

Date

JUL 17 1929

CHAS. L. SHERWOOD

19

Scout

Cowley

Map No. **KANSAS**

Sec. 17 Twp 34 R. 3

Well No. 6 Baird

Shawyer exal Company

Contractor

COMPLETE

SECTION PLAT

660 Ft. from N. Line

..... Ft. from S. Line

660 Ft. from E. Line

..... Ft. from W. Line

			0

ABANDONED

Location.....

Rig up.....

Drilling and Remarks:

RECORD

Cased..... in., ft.

Sand.....

Gas.....

Oil.....

Total Depth..... 1963

PRODUCTION

1st 24 hrs. Nat.....

1st 24 hrs. after shot.....

Gas..... Cu. Ft.

Dry Hole

Abandoned

Date

NOV 13 1929

CHAS. L. SHERWOOD

..... 192..... Scout