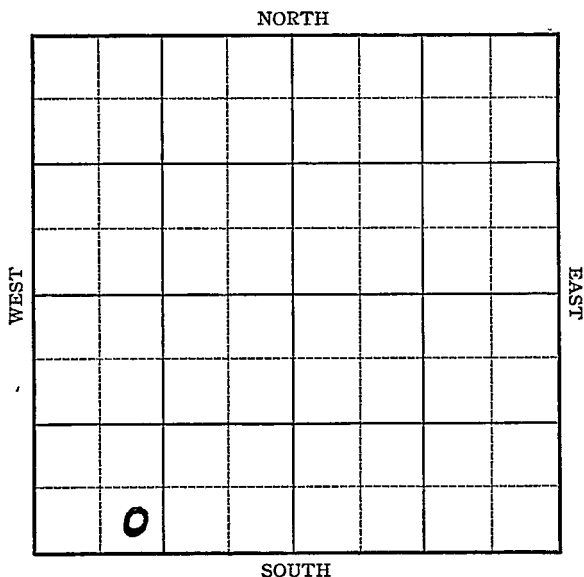


Section 31 Township 18 Range 7WWell No. 2 BoltonCompany Sinclair Prairie

Rice KANSAS

Map No. 45 Sec. 31 Twp. 18 R. 7WWell No. 2 - BoltonLinclair Prairie Company

Contractor

FIRST REPORT

SECTION PLAT

0			

_____ Ft. from N. Line

330 Ft. from S. Line

_____ Ft. from E. Line

990 Ft. from W. Line

Location _____

Rig up _____

Drilling and Remarks:

RR

RECORD

Cased _____ in., _____ ft.

Sand _____

Gas _____

Oil _____

Total Depth _____

PRODUCTION

1st 24 hrs. Nat. _____

1st 24 hrs. after shot _____

Gas _____ Cu. Ft.

Dry Hole _____

Abandoned _____

Date

JUL 28 1934

H. D. Hatfield

Scout

Rice KANSASMap No. _____ Sec. *31* Twp. *18* R. *7W*Well No. *2 - Bolton**Sinclair Prairie* Company

Contractor _____

COMPLETED

_____ Ft. from N. Line

530 Ft. from S. Line

_____ Ft. from E. Line

990 Ft. from W. Line

SECTION PLAT

Location _____

Rig up _____

Drilling and Remarks:

ROT-1438

RECORD

Cased *7* in. *3235* ft.Sand *511 3235*

Gas _____

Oil _____

Total Depth *3238*

PRODUCTION

1st 24 hrs. Nat. _____

1st 24 hrs. after shot _____

Gas _____ Cu. Ft.

Dry Hole _____

Abandoned _____

Date

SEP 1 1937 19

H. D. Hatfield Scout