

KANSAS

FORM 51 5M 4-41 PETROL


Cowley

Section 17 Township 34 Range 3-E

Well No. 2 Baird "B"

Company E. B. Shawver

NORTH Miscellaneous

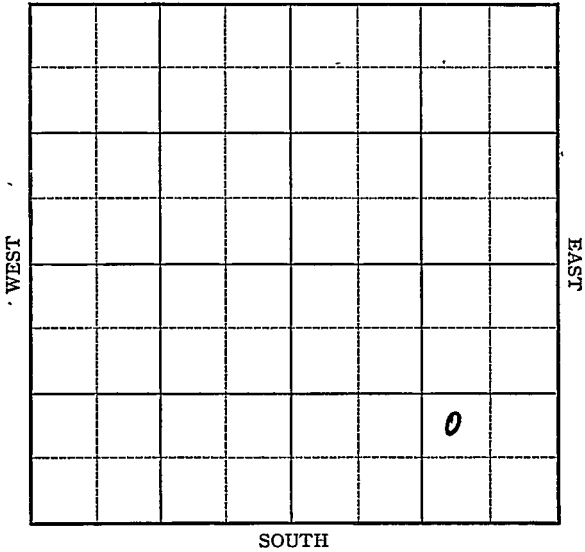

Sec. 17 Twp. 34 R. 3-E

Well No. #2 Baird "B" Farm

E. B. Shawver Company


(Misc.)

 Ft. from N. Line

990 Ft. from S. Line

990 Ft. from E. Line

 Ft. from W. Line

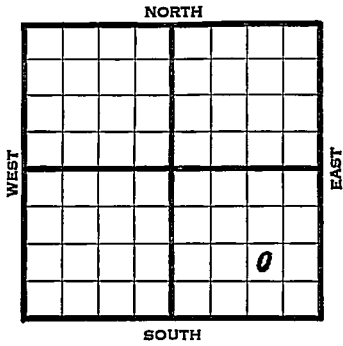

1941	REPORT
8/27	Derrick.
9/4	10" - 99' Drlg. 1500'
9/11	Drlg. 2985'
9/18	Bart. 3343' 7" - 3324'
	T.D. 3347' WOC.
9/25	Miss. 3373' T.D. 3395'
	SO & W.
10/1	Miss. 3373'
	T.D. 3395'
	Water.
	ABANDONED

