

Sec. 31 Twp. 18 R. 7-W

Well No. #3 Bolton Farm _____

Phillips Company

(Geneseo)


1175 Ft. from N. Line

_____ Ft. from S. Line

_____ Ft. from E. Line

255 Ft. from W. Line

Elev. 1706

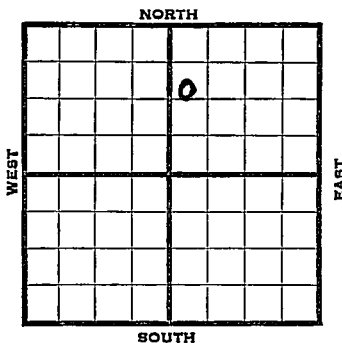

1938	REPORT
12/28	Cellar.
1939	
1/6	10" - 247'. WOC.
1/13	Drig. 2400'.
1/20	Arb. 3204-06' T.D. 7" - ³²⁰⁴ 3205 '.
	RUST.
1/27	"
2/3	Drilled plug. 280' oil in 1 hr.
2/10	2850' oil. Swab 50 oil in 1 hr.
2/15	7" - 3204' (Corrected)
	Arb. 3204'
	T. D. 3206'
	500 acid.
	Pump 704 bbls. 8 hours.
	Potential 2112 bbls.
	COMPLETED

Map No. 45 Sec. 31 Twp. 18 R. 7WWell No. 3 BoltonPhillips

Company

Contractor

FIRST REPORT

Approx.

1175 Ft. from N. Line

_____ Ft. from S. Line

_____ Ft. from E. Line

255 Ft. from W. Line

GENESEO POOL

SECTION PLAT

		○	

Location _____

Rig up _____

Drilling and Remarks:

Cellar

RECORD

Cased _____ in., _____ ft.

Sand _____

Gas _____

Oil _____

Total Depth _____

PRODUCTION

1st 24 hrs. Nat. _____

1st 24 hrs. after shot _____

Gas _____ Cu. Ft.

Dry Hole _____

Abandoned _____

Date

DEC 28 1938

19

H. D. Hatfield Scout

Map No. 45 Sec. 31 Twp. 18 R. 7WWell No. 3 BoltonPhillips

Company

Contractor

COMPLETED

Approx.

C W L N E

1175 Ft. from N. Line

_____ Ft. from S. Line

_____ Ft. from E. Line

255 Ft. from W. Line

SECTION PLAT

		0	

GENESEO POOL

Location _____

Rig up _____

Drilling and Remarks:

500 AcidP-704 1/8POT 2112

RECORD (corrected)

Cased 7 in., 3204 ft.Sand Arb 3204

Gas _____

Oil _____

Total Depth 3206

PRODUCTION

1st 24 hrs. Nat. _____

1st 24 hrs. after shot _____

Gas _____ Cu. Ft.

Dry Hole _____

Abandoned _____

Date

FEB 15 1939

19

H. D. Hatfield Scout