

9-7-552

Rice

O.W.W.O.

FORM 51 5M 2-38 TPCO.

11-30-552


KANSAS

O.W.W.O.

Section 31 Township 18 Range 7-W

Well No. 3 Powell

Company Continental

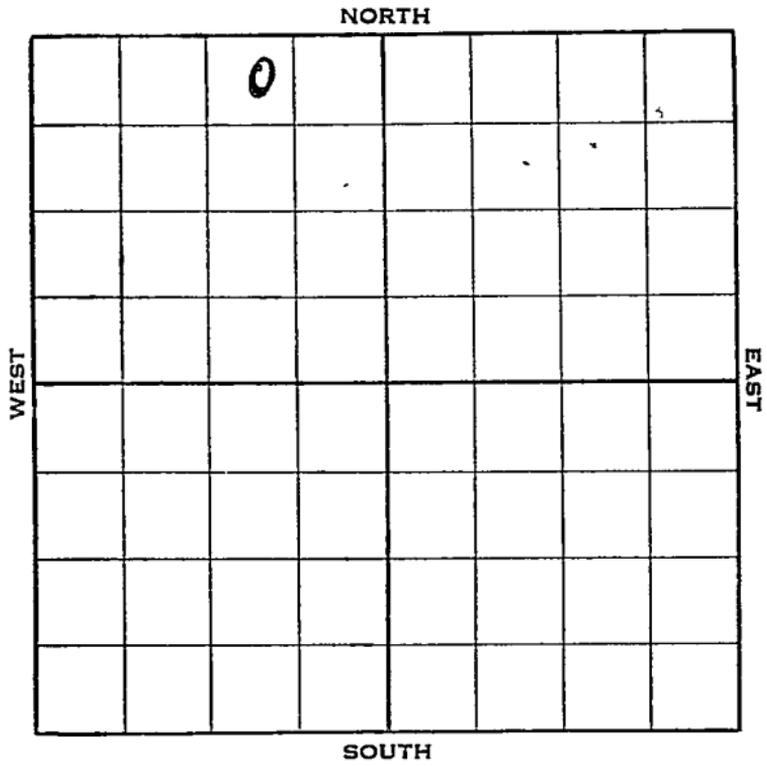

9-7-55
FORM 5527-55
O.W.W.O.

11-30-55
O.W.W.O.

Rice

KANSAS

Sec. 31 Twp. 18 R. 7-W

Well No. #3 Powell Farm

Continental Company

Genesee Pool

330 Ft. from N. Line


Ft. from S. Line

750 Ft. from E. Line

1890 Ft. from W. Line

~~C N/2 NE NW~~

Elev. 1701', NW NE NW

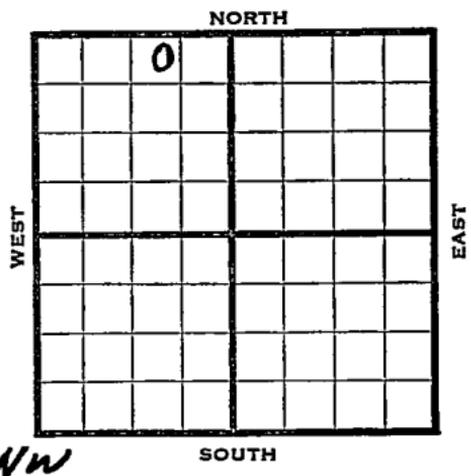

1938	1701' Elev.	REPORT
10/12	S. H.	
10/21	10" - 215'	Dlg. 2575'
10/28	Arb. 3177'	T.D. 3179'
	7" - 3178'	RUST.
11/2	7" - 3178'	
	Arb. 3177'	
	T. D. 3192'	
	5000 acid.	
	Potential 878 bbls.	
	COMPLETED	
1955	O.W.W.O.	
9/7	OTD 3192'	7" @ 3178 SP 3165
	GO to 3165.	50/3135-57 B/2 GO
	1/4 GW 3 hrs.	PB 3163 frac.
	S/27 BO 1/2 BWPH 3 hrs.	
	Comp. 180 BOPD	21 BW
	Shale 3135', Arb. 3177'	
	TD 3192'	
	FIRST REPORT	
	COMPLETED	
	OVER	

1955
11/30

O.W.W.O.

DUAL COMP. OTD 3192'
5" @ 3176 CO to 3189 SP 3165
P/99 BO 9 BW from Simp.
P/4 BO 25 BW from Arb. per day.
Comp. S. 3118', A. 3176'
TD 3192'

FIRST REPORT



COMPLETED

Map No. 45 Sec. 31 Twp. 18 R. 7W

Well No. 3 Powell

Continental

Company

Contractor

FIRST REPORT

Approx.

330 NW NE NW
Ft. from N. Line

_____ Ft. from S. Line

750 Ft. from E. Line

_____ Ft. from W. Line

SECTION PLAT

	0		

Location _____

Rig up _____

Drilling and Remarks:

SH

*Company to be kept
in case
resp.*

RECORD

Cased _____ in., _____ ft.

Sand _____

Gas _____

Oil _____

Total Depth _____

PRODUCTION

1st 24 hrs. Nat. _____

1st 24 hrs. after shot _____

Gas _____ Cu. Ft.

Dry Hole _____

Abandoned _____

Date

OCT 12 1938 19

H. D. Hatfield Scout

Rice KANSAS

Map No. 45 Sec. 31 Twp. 18 R. 7WWell No. 3 PowellContinental

Company

Contractor

COMPLETED

Approx.

NW NE NW

330 Ft. from N. Line

_____ Ft. from S. Line

750 Ft. from E. Line

_____ Ft. from W. Line

SECTION PLAT

	0		

Location _____

Rig up _____

Drilling and Remarks:

5000 AcidPot 878

RECORD

Cased 7 in., 3178 ft.Sand A56 3177

Gas _____

Oil _____

Total Depth 3192

PRODUCTION

1st 24 hrs. Nat. _____

1st 24 hrs. after shot _____

Gas _____ Cu. Ft.

Dry Hole _____

Abandoned _____

Date

NOV 2 - 1938 19H. D. Hatfield Scout

O.W.W.O.

FORM 513 REV. SUNRAY



County Rice Elev. 1791
 Sec. 31 Twp. 7S Rge. 7W
 Company Continental Oil
 FarmName J. Powell No. 3

TOPS	DEPTH	LOG	DATUM
Anb.			
Tp.			
H.			
Tr.			
Dg.			
Bl.			
L.			
K.C.			
B.K.C.			
Ce.			
C.			
M.			
M.			
K.			
Mz.			
Ma.			
V.			
S.	3135		
S.			
A.	3177		
R.			
PE.			
G.			
T.D.	3192		

Loc. in Sec. C N $\frac{1}{2}$ NE NW
 Geol. Genesee
 Contr. Genesee
 Pool Genesee

0
 SEP 7 1955
 FIRST REPORT
 COMPLETE

Date Comm. OTD 3192 7" @ 3178 SP 3165 CO Bo 3165
50/ 3135-57 B/ 2 go $\frac{1}{4}$ gw 3 hr. PB 3163
frac S/ 27 bo $\frac{1}{2}$ bwph 3 hr.
Comp. 180 bopd 21 bw

Co. Lse. No. Sec. T. R.

O.W.W.O.

FORM 513 REV. SUNRAY

O.W.W.O.

County Rice Elev. 1701

Sec. 31 Twp. 18 Rge. 7W

Company Continental

Farm Name J. Powell No. 3

TOPS	DEPTH	LOG	DATUM	Loc. in Sec.
Anh.				NW NE NW
Tr.				1890' WL
Dg.				
Bl.				
L.				Geol.
K.C.				Contr.
B.K.C.				
Ce.				
C.				
M.				Pool
M.				Geneseo
K.				
Mz.				
Me.				
V.	3118			<div style="border: 1px solid black; padding: 5px;"> <p>°</p> <p>FIRST REPORT</p> <p>NOV 30 '55</p> <p>COMPLETE</p> </div>
S.				
S.	3176			
A.				
R.				
Pe.				
G.				
Ed.	3192			

Date Comm. Dual Comp.

5" @ 3176 CO to 3189 SP 3165

P/ 99 bo 9 bw from Simp. P/ 4 bo

25' bw from Arb. per day Comp.