


Rice

KANSAS

Section 31 Township 18 Range 7-W

Well No. 3 Bolton

Company Continental et al

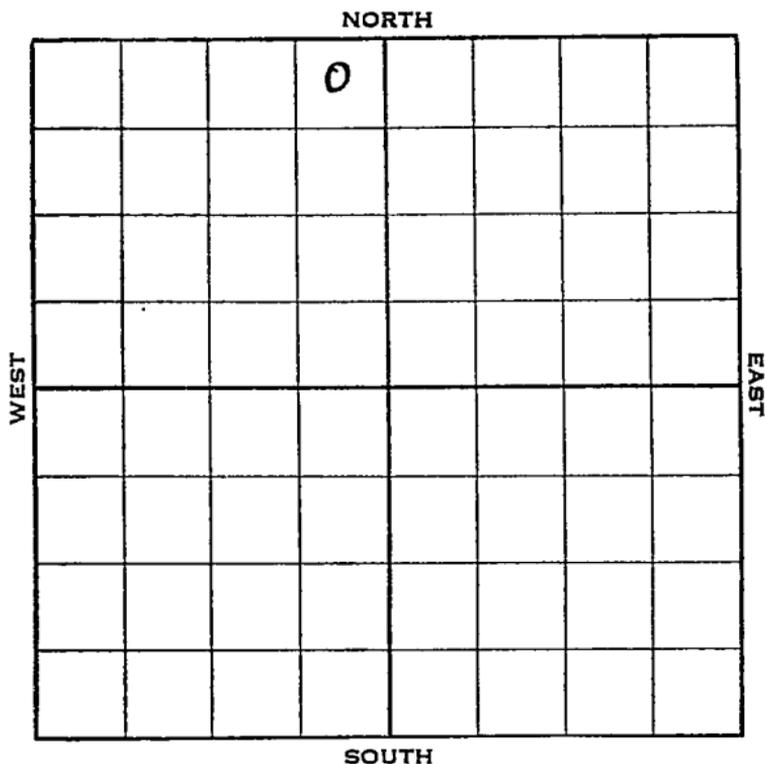

Rice

KANSAS

Map No. 45 Sec. 31 Twp. 18 R. 7WWell No. 3 BoltonContinental etal Company

Contractor

FIRST REPORT

SECTION PLAT

NE NW

337 Ft. from N. Line

_____ Ft. from S. Line

225 Ft. from E. Line

_____ Ft. from W. Line

	0		

Location _____

Rig up _____

Drilling and Remarks:

RR

RECORD

Cased _____ in., _____ ft.

Sand _____

Gas _____

Oil _____

Total Depth _____

PRODUCTION

1st 24 hrs. Nat. _____

1st 24 hrs. after shot _____

Gas _____ Cu. Ft.

Dry Hole _____

Abandoned _____

Date

SEP 14 1938 19

H. D. Hatfield Scout

Map No. 45 Sec. 31 Twp. 18 R. 7WWell No. 3 BoltonContinental etal Company

Contractor

COMPLETED

NE NW

337 Ft. from N. Line Ft. from S. Line225 Ft. from E. Line Ft. from W. Line**SECTION PLAT**

	0		

Location _____

Rig up _____

Drilling and Remarks:

*2000 acid**LOT 2239***RECORD**Cased 7 in. 3189 ft.Sand ATB 3188 ..

Gas _____

Oil _____

Total Depth 3200**PRODUCTION**

1st 24 hrs. Nat. _____

1st 24 hrs. after shot _____

Gas _____ Cu. Ft.

Dry Hole _____

Abandoned _____

Date

OCT 12 1938 19

H. D. Hatfield Scout