


Company Messman & Hiehart

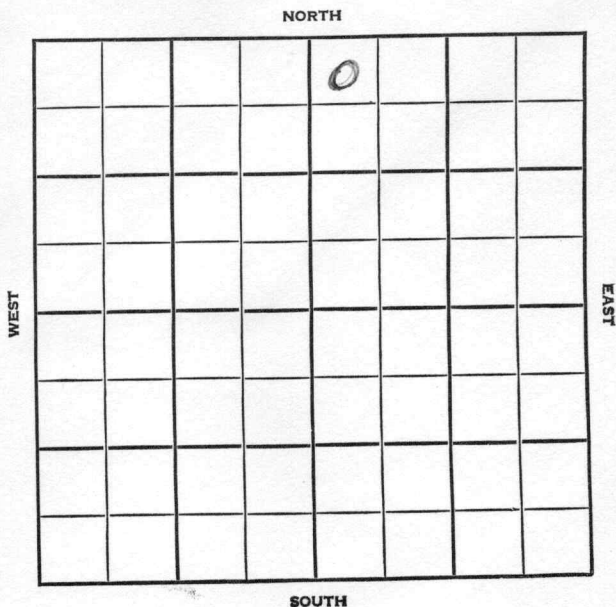

County Rice Elev. _____Sec. 31 Twp. 18 Rgs. 7WCompany Messman & KiehartFarm Name Bolton No. 3

TOPS	DEPTH	LOG	DATUM	Loc. in Sec.
Anh.				NW NW NE
TP.				
H.				140 N' of
Tr.				old hole
Dg.				
BL.				
L.				Geol.
K.C.				Contr.
B.K.C.				Graham-Michaelis
Ce.				
C.				
M.				Pool
M.				Geneseo
K.				
Mz.				
Mq.				
V.				
S.				
S.				
A.				
R.				
Pe.				
G.				
TD.				

Date Comm. _____

Location _____

XZ

#2 Road
Comp.
TD 3189

FORM 512 SURVAY

Our map room shows a #2 Well completed
at a TD of 3189' in this same spot.
Please advise.

TOPS	DEPTH	LOG	DATUM	Loc in Sec.

Date Comm.
Location

First Report

County Rice Elev. 1705
 Sec. 31 Twp. 18 Rgs. TW
 Company Messman & Riehart
 Farm Name Bolton No. 3

TOPS	DEPTH	LOG	DATUM	Loc. in Sec.
Anh.				NW NW NE
TP.				
H.	2605			140' of all
Tr.				holes
Dg.				
BL.	2731			
L.	2764			Geol.
K.C.				
B.K.C.				Contr.
Ce.				Graham-Michaclis
C.				
M.				Pool
M.				Genesee
K.				
Mz.				
Mo.				
V.				
S.				0
S.	sd 3155	3152		JAN 30 '57
A.	3183	3181		
R.				
PE.				
G.				
TD.	3190			ABANDONED

Date Comm.

Location DEC 8 '56 12-1-56 85/8

217/175 1690 DEC 12 '56 5 1/2 3180

150 WOCT DEC 19 '56 MCT DEC 26 '56 CO

32/3154-62 1st 5 1/2 Gwph.

1/4 Frac 6x6 POP P. 7

BFph 70% wtr 6 hrs JAN 2 '57

P. 5 BFph 85% wtr.

JAN 9 '57 P. 4 BO + 159 BW in

5 days.

JAN 15 '57

JAN 28 '57

JAN 30 '57

D&A