

Rice


KANSAS

Form 51-5M 5-37 Petrol

Section 31 Township 18 Range 7-W

Well No. #4 Bolton

Company Sinclair-Prairie

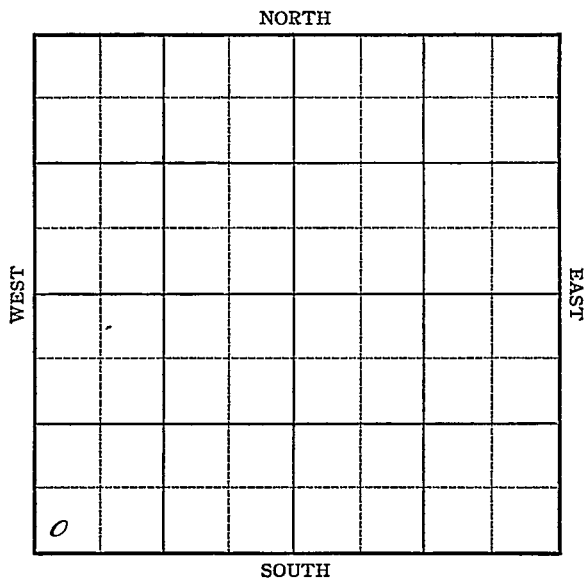

Rice

KANSAS

Map No. _____ Sec. 31 Twp. 18 R. 7WWell No. 4-BoltonSinclair Prairie Company

Contractor _____

FIRST REPORT
SW/C

SECTION PLAT

_____ Ft. from N. Line

330 Ft. from S. Line

_____ Ft. from E. Line

330 Ft. from W. Line

Location _____

Rig up _____

Drilling and Remarks:

SH

RECORD

Cased _____ in., _____ ft.

Sand _____

Gas _____

Oil _____

Total Depth _____

PRODUCTION

1st 24 hrs. Nat. _____

1st 24 hrs. after shot _____

Gas _____ Cu. Ft.

Dry Hole _____

Abandoned _____

Date

SEP 29 1937 19 _____ H. D. Hatfield Scout

KANSAS

Rice

Map No. 45 Sec. 31 Twp. 18 R. 7WWell No. 4 BoltonSinclair Prairie Company

Contractor

COMPLETED

SW/C

 Ft. from N. Line330 Ft. from S. Line Ft. from E. Line330 Ft. from W. Line

SECTION PLAT

0

Location Rig up

Drilling and Remarks:

RECORD

Cased 7 in., 3215 ft.Sand 511 3215Gas Oil Total Depth 3232

PRODUCTION

1st 24 hrs. Nat. 1st 24 hrs. after shot Gas Cu. Ft.Dry Hole Abandoned

Date

OCT 27 1937

19

H. D. Hatfield Scout