


Rice

Section 31 Township 18 Range 7-W

Well No. 7 Bolton

Company Sinclair-Prairie

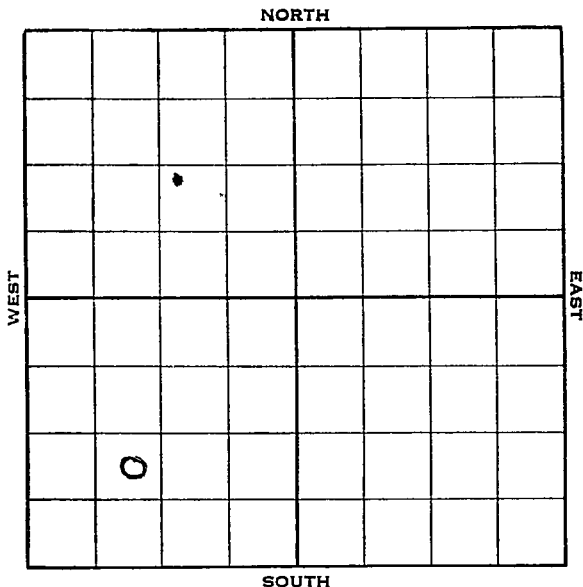

KANSAS

Rice

Sec. 31 Twp. 18 R. 7-W

Well No. #7 Bolton Farm
Sinclair-Prairie Company


_____ Ft. from N. Line

990 Ft. from S. Line

_____ Ft. from E. Line

990 Ft. from W. Line

Elev. 1754'.

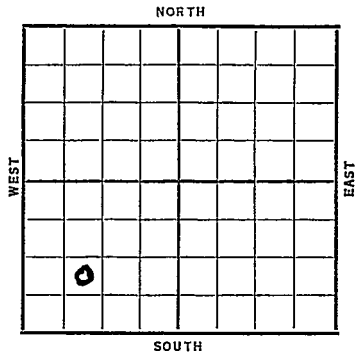

Date	REPORT
1938	
2/9	Cellar.
2/18	B. R. R.
2/26	13" @ 136'.
	WOC.
3/4	Drlg. 2392'.
3/11	Coring 3245'.
3/16	Arb. 3268'.
	T.D. 3282'.
	Spotted sat. 3272-73'.
	ABANDONED

Rice KANSASMap No. _____ Sec. 31 Twp. 18 R. 7WWell No. 7 BoltonSinclair Prairie

Company _____

Contractor _____

FIRST REPORT**SECTION PLAT**

NE SW SW

_____ Ft. from N. Line

990 Ft. from S. Line

_____ Ft. from E. Line

990 Ft. from W. Line

.			
o			

Location _____

Rig up _____

Drilling and Remarks:

Cellar**RECORD**

Cased _____ in., _____ ft.

Sand _____

Gas _____

Oil _____

Total Depth _____

PRODUCTION

1st 24 hrs. Nat. _____

1st 24 hrs. after shot _____

Gas _____ Cu. Ft.

Dry Hole _____

Abandoned _____

Date

FEB 9 1938

19

H. D. Hatfield

Scout

Rice

KANSAS

Map No. 45 Sec. 31 Twp. 18 R. 7W

Well No. 7 Bolton

Sinclair Prairie Company

Contractor

ABANDONED

NE SW SW

_____ Ft. from N. Line

990 Ft. from S. Line

_____ Ft. from E. Line

990 Ft. from W. Line

SECTION PLAT

0			

Location _____

Rig up _____

Drilling and Remarks:

Spotted sat, 3272-913

DVA

RECORD

Cased _____ in., _____ ft.

Sand Arb 3268

Gas _____

Total Depth 3282

PRODUCTION

1st 24 hrs. Nat. _____

1st 24 hrs. after shot _____

Gas _____ Cu. Ft.

Dry Hole _____

Abandoned _____

Date

MAR 16 1938

H. D. Hatfield

19

Scout