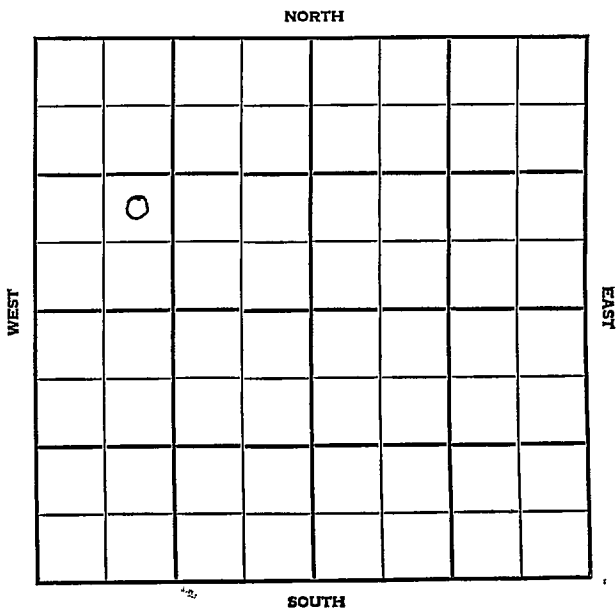


Section 16 Township 14 Range 17 WWell No. #3 DinkleCompany Leben Oil

ELLIS KANSAS
SEC. 16 TWP. 14 R. 17W

WELL NO.
#3Dinkle FARM

COMPANY
Leben Oil

CONTRACTOR
Leben

SE Toulon


Ft. from N. Line

Ft. from S. Line

Ft. from E. Line

Ft. from W. Line

NE SW NW

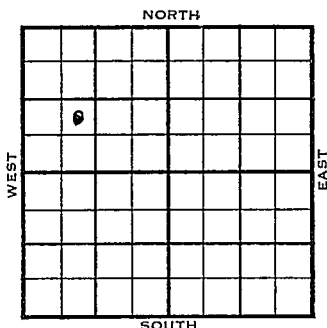

1955 ELEVATION REPORT FIRST REPORT

8/10 8-5-55
8" @1179 Drlg 2370
8/17 DST 3432-48 open 1 hr. Rec. 12' mud
0;20" D&A
H: 3220
L: 3266,
C: 3511,
TD: 3662

ABANDONED

County Ellis Elev. 17W
 Sec. 16 Twp. (14) Rge. 17W
 Company Leben Oil
 FarmName Dinkle No. 3

TOPS	DEPTH	LOG	DATUM	Loc. in Sec.
Anh.				NE SW NW
TP.				
H.				
Tr.				
Dg.				
Bl.				
L.				Geol.
K.C.				Contr.
B.K.C.				Leben
Ce.				Pool
C.				SE Toulon
M.				
M.				
K.				
Mz.				
Mq.				
V.				
S.				
S.				
A.				
R.				
PE.				
G.				
T.D.				


Date Comm. 8-5-55
8" @ 1179 drlg. 2370

(Handwritten signature)

FAIR REPORT
 AUG 10 - 55

County Ellis Elev. _____
 Sec. 16 Twp. N1 Rge. 17W
 Company Leben Oil
 FarmName Dinkle No. 3

TOPS	DEPTH	LOG	DATUM	Loc. in Sec.
Anh.				NE SW NW
Tr.				
Dg.				
Bl.				
L.	3220			
K.C.				Geol. _____
B.K.C.				Contr. _____
Ce.				Leben
C.	3511			Pool _____
M.				SE Toulon
Mz.				
Ma.				
V.				
S.				
S.				
A.				
R.				
Pe.				
G.				
T.D.	3562			

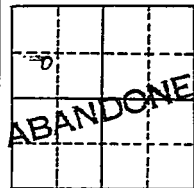

Date Comm. 8-5-55 AUG 17 1955

8" @ 1179 DST 3432-48 open 1 hr.

Rec. 12' mud 0/20"

D & A