


Section 16 Township 11S Range 17W

Well No. 1 Hertel

Company Leben Oil

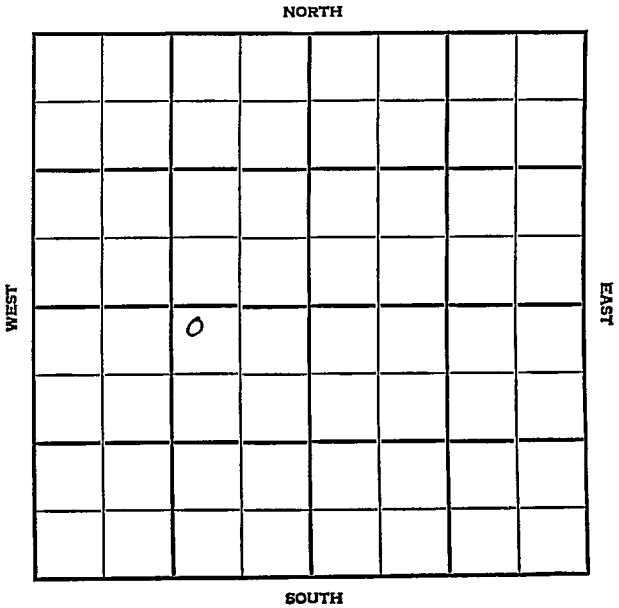

Ellis

KANSAS

| | | |
|------------|--------------|------------|
| SEC. 16 | TWP. 14 S | R. 17 W |
|------------|--------------|------------|

WELL NO. # 1 Hertel FARM

COMPANY Leben Oil

CONTRACTOR Ferrell (Jim Condon-Geol)


Toulon, SE

_____ Ft. from N. Line

_____ Ft. from S. Line

_____ Ft. from E. Line

_____ Ft. from W. Line

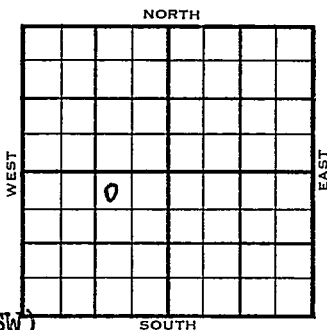

NW NE SW

1/4 Mi - SD-X (DS-E/2 SW)

Carter FO

| 1955 | ELEVATION | | REPORT |
|------|-----------|------|--------|
| | 1955 | 1989 | |

7/13

Spud 7-9-55
8" @ 1171 w/550 WOC

7/20

Comm 7-9-55
Anh 1165
Tp 2966
H 3219
L 3266
A 3566
TD 3582
8" @ 1171
D & A

ABANDONED

County Ellis Elev. _____
 Sec. 16 Twp. (11/8) Rgs. 17W
 Company Leben Oil
 FarmName Hertel No. 1

| TOPS | DEPTH | LOG | DATUM |
|--------|-------|-----|-------|
| Anb. | | | |
| TP. | | | |
| H. | | | |
| Tr. | | | |
| Dg. | | | |
| Bl. | | | |
| L. | | | |
| K.C. | | | |
| B.K.C. | | | |
| Ce. | | | |
| C. | | | |
| M. | | | |
| M. | | | |
| K. | | | |
| Mz. | | | |
| Ma. | | | |
| V. | | | |
| S. | | | |
| S. | | | |
| A. | | | |
| R. | | | |
| PE. | | | |
| G. | | | |
| TR. | | | |

Loc. in Sec. _____
 NW NE SW
 DS-E/2 SW
 Carter FO
 Geol. Jim Condon
 Contr. _____
Ferrell
 Pool _____
 Toulon, SE

1/4 mile
 FIRST REPORT
10
JUL 13 1955


Date Comm. spd 7/9/55 8ⁿ 1171 w/550 WOC

Co.
 Lse.
 No.
 Sec.
 T.
 R.

County Ellis Elev. 1989
 Sec. 16 Twp. 14 Rge. 17W
 Company Leben Oil
 Farm Name Hertel No. 1

| TOPS | DEPTH | LOG | DATUM |
|--------|-------|-----|-------|
| Anh. | 1165 | | |
| Tp. | 2966 | | 977 |
| H. | 3219 | | 1236 |
| Tr. | | | |
| Dg. | | | |
| BL. | | | |
| L. | 3266 | | 1277 |
| K.C. | | | |
| B.K.C. | | | |
| Ce. | | | |
| C. | | | |
| M. | | | |
| M. | | | |
| K. | | | |
| Mz. | | | |
| Mq. | | | |
| V. | | | |
| S. | | | |
| S. | | | |
| A. | 3566 | | 1577 |
| R. | | | |
| PE. | | | |
| G. | | | |
| TD. | 3582 | | |

Loc. in Sec. NW NE SW
 Geol. _____
 Contr. _____
Cornell
 Pool SE Toulon

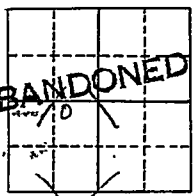

Date Comm. 7-9-55 JUL 20 1955
8" @ 1171

D & A

Co.

Lse.

No.

Sec.

T.

R.