

KANSAS

Rice

Form 51—5M—7-40—Palace

Section 31 Township 18 Range 7-W

Well No. 4 Powell

Company Continental

NORTH Geneseo Pool

[illegible]

SOUTH

Sec. 31 Twp. 18 R. 7-WWell No. #4 Powell FarmContinental Company

(Geneseo)


990 Ft. from N. Line

Ft. from S. Line

Ft. from E. Line

330 Ft. from W. Line

Elev. 1730

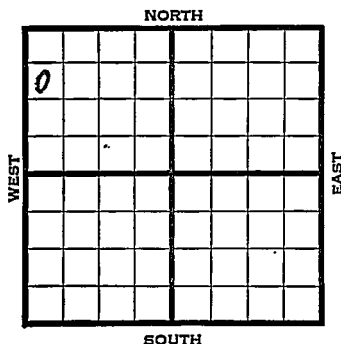

1941

REPORT

1/8

Location

1/16

10" - 210' Drig. 2117'

1/23

Simp. sand ³¹⁸⁰~~3191~~-3222'Arb. ³²³²~~3222~~-41' T.D.

Water 3205' Run 6".

1/30

6" - 3233' RUST.

2/5

Arb. 3232'

6" - 3233'

Simp. sand 3180' (Corrected)

T.D. 3233'

36 shots 3182-90'

6 " 3190-94'

Potential 150 bbls., pump.

42. Gravity

Map No. 45 Sec. 31 Twp. 18 R. 7WWell No. 4 Powell

Continental

Company

Contractor

FIRST REPORT

SW NW NW

990 Ft. from N. Line Ft. from S. Line Ft. from E. Line330 Ft. from W. Line

SECTION PLAT

o			

GENESEO POOL

Location XRig up

Drilling and Remarks:

RECORD

Cased in., ft.Sand Gas Oil Total Depth

PRODUCTION

1st 24 hrs. Nat. 1st 24 hrs. after shot Gas Cu. Ft.Dry Hole Abandoned

Date

JAN 8 1941

19

S. J. LEWIS Scout

Map No. 45 Sec. 31 Twp. 18 R. 7WWell No. 4 PowellContinental CompanyCOMPLETED Contractor

SECTION PLAT

990 SW NW NW
Ft. from N. Line

Ft. from S. Line

Ft. from E. Line

330 Ft. from W. Line

GENESEO POOL

a			

Location _____

Rig up _____

Drilling and Remarks:

*Per 3232**6" @ 3233**8 mph 20 L. 3180 connected.**36 Sk & to 3182-90**6 " 3190-94**Pump 150 P & Y**42 @ Gr.*

RECORD

Cased _____ in., _____ ft.

Sand _____

Gas _____

Oil _____

Total Depth *3233*

PRODUCTION

1st 24 hrs. Nat. _____

1st 24 hrs. after shot _____

Gas _____ Cu. Ft.

Dry Hole _____

Abandoned _____

Date

FEB 5 1941 19S. J. LEWIS Scout

Please check: Top Arb.
Top Simp.
Total depth

Paul.

Misc. Small Maps	_____
Cards	_____
Tracing	_____
France Map	_____
Scarborough Map	_____
Moody Map	_____
Cecological Dept.	_____
Moody Flat Book	_____