KANSAS


Form 51—5M—7-40—Palace

Rice

Section 31 Township 18 Range 7-W

Well No. 5 Powell

Company Continental

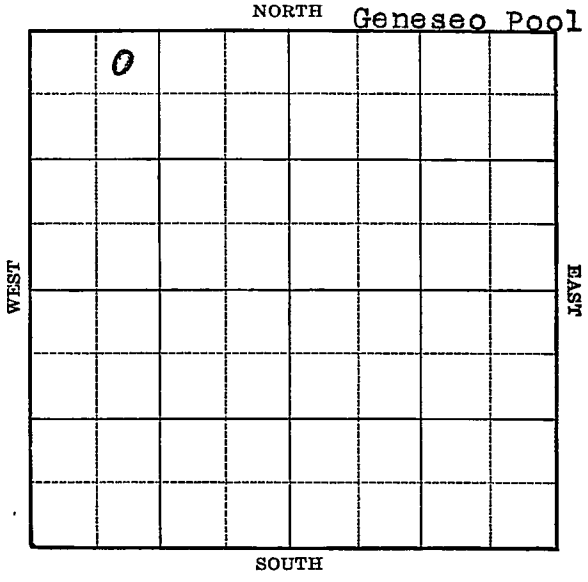

FORM 252-A 5M 2-40

KANSAS Rice

Sec. 31 Twp. 18 R. 7-W

Well No. #5 Powell Farm

Continental Company

(Geneseo)


330 Ft. from N. Line

Ft. from S. Line

Ft. from E. Line

990 Ft. from W. Line

Elev. 1730

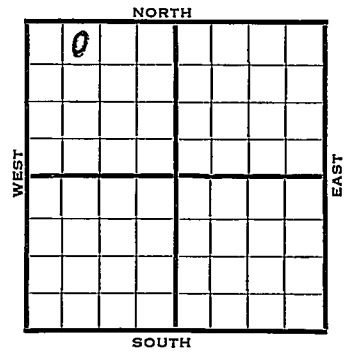

1941	REPORT
1/29	Derrick.
2/6	9" - 195' Drlg. 510'
2/13	Fsg. 3056'
2/20	Arb. 3226-30' T.D.
	S.O. In K.C. 2790-2800'
	" " " 2915-30'
	" " " 2960-73'
	S.O. in Simpson 3163-83'
	6" - 3227' RUST.
2/26	Arb. 3226'
	6" - 3227'
	T.D. 3230'
	1000 acid.
	Echometer potential 6338 bbls.
	Maximum 3000 bbls.
	40.1 Gravity
	COMPLETED

Form 26—200 Bks.—1-40—Palace Rice KANSAS

Map No. 45 Sec. 31 Twp. 18 R. 7W

Well No. 5 Powell

Continental Company

Contractor

FIRST REPORT

NE NW NW

330 Ft. from N. Line


Ft. from S. Line

Ft. from E. Line

990 Ft. from W. Line

GENESEO POOL

SECTION PLAT

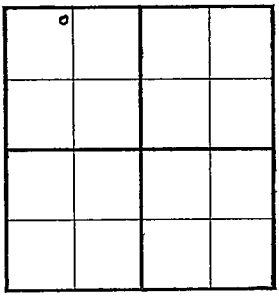

Location

Rig up

Drilling and Remarks:

Derrick

RECORD

Cased in., ft.

Sand

Gas

Oil

Total Depth

PRODUCTION

1st 24 hrs.-Nat.

1st 24 hrs. after shot

Gas Cu. Ft.

Dry Hole

Abandoned

Date

JAN 29 1941 19

S. J. LEWIS Scout

Form 26—200 Bks.—1-40—Palace Rice KANSAS

Map No. 45 Sec. 31 Twp. 18 R. 7W

Well No. 5 Powell

Continental Company

Contractor

COMPLETED

NE NW NW

330 Ft. from N. Line


Ft. from S. Line

Ft. from E. Line

990 Ft. from W. Line

GENESEO POOL

SECTION PLAT

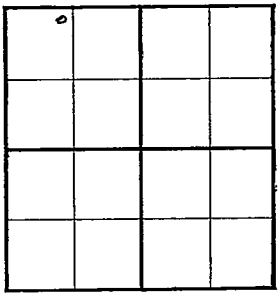

Location

Rig up

Drilling and Remarks:

Cr 3226
6" @ 3227
1000 acid
Echo Pet. 6338
Max 3000.
40 - Gr.

RECORD

Cased in., ft.

Sand

Gas

Oil

Total Depth 3230

PRODUCTION

1st 24 hrs. Nat.

1st 24 hrs. after shot

Gas Cu. Ft.

Dry Hole

Abandoned

Date

FEB 26 1941 19

S. J. LEWIS Scout