


DX 78-1 Ellis

KANSAS

Section 20 Township 14S Range 17W

Well No. #1 Hammerschmidt

Company Sierra Drlg.

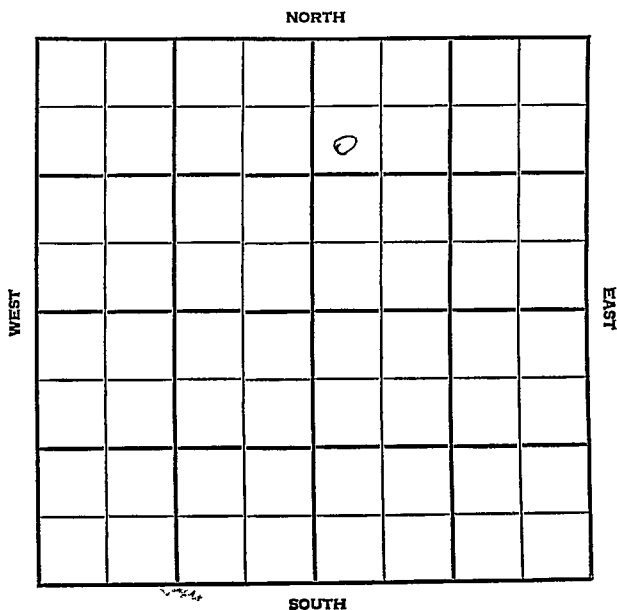

Ellis

KANSAS

SEC.

20

TWP.

... 14

R.

17W

WELL NO.

#1 Hammerschmidt

FARM

COMPANY

Sierra Drlg.

CONTRACTOR

Co.

Heyl

890

FT. FROM N. LINE

FT. FROM S. LINE


FT. FROM E. LINE

250

FT. FROM W. LINE

SW NW NE

NORTH

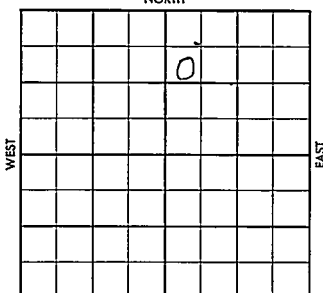

SOUTH

SDX  $\approx$  3/8 mile

ELEVATION

1956

1970'

REPORT

8-1

WORT

8-9

Spud 8-2-56  
 8 5/8" @ 1163 w/550  
 Drlg. 2255'

8-16

Heeb. 3212'; Tor. 3232'; Lans. 3257';  
 DST 3509-15, op 1 hr, rec. 30' ocm,  
 980/30".

TD 3515'

5 1/2" @ 3510 w/140

8-23

CO 3515'

B/ 15 boph, 2 hrs.; 250 A

S/ 54 1/2 bo, 2% wtr., 15 hrs.

POP

9-6

NR

**COMPLETED**

County Ellis Elev. \_\_\_\_\_  
Sec. 20 Twp. 14S Rgs. 17W  
Company Sierra Drilling  
Farm Name Hammerschmidt No. 1

| TOPS   | DEPTH | LOG | DATUM |
|--------|-------|-----|-------|
| Anh.   |       |     |       |
| TP.    |       |     |       |
| H.     |       |     |       |
| Tr.    |       |     |       |
| Dg.    |       |     |       |
| BL.    |       |     |       |
| L.     |       |     |       |
| K.C.   |       |     |       |
| B.K.C. |       |     |       |
| Ce.    |       |     |       |
| C.     |       |     |       |
| M.     |       |     |       |
| M.     |       |     |       |
| K.     |       |     |       |
| Mz.    |       |     |       |
| Me.    |       |     |       |
| V.     |       |     |       |
| S.     |       |     |       |
| S.     |       |     |       |
| A      |       |     |       |
| R.     |       |     |       |
| PE.    |       |     |       |
| G.     |       |     |       |
| T.D.   |       |     |       |

Loc. in Sec. SW NW NE

Geol. \_\_\_\_\_  
Contr. \_\_\_\_\_  
Co. \_\_\_\_\_

Pool \_\_\_\_\_  
Heyt \_\_\_\_\_

3/8 mile

FIRST REPORT

Date Comm. AUG 1 1956  
WORT

2301 7 c 4  
2.1

County Ellis Elev. 1970  
 Sec. 20 Twp. 14N Rge. 17W  
 Company Sierra Drilling  
Hammerschmidt No. 1

|        | DEPTH | LOG | DATUM | Loc. in Sec. |
|--------|-------|-----|-------|--------------|
| Ad.    |       |     |       | SW NW NE     |
| Tr.    |       |     |       |              |
| H.     | 3212  |     |       | 890 NL       |
| Tr.    | 3232  |     |       | 250 WL       |
| Dg.    |       |     |       |              |
| Bl.    |       |     |       |              |
| L.     | 3252  |     |       |              |
| K.C.   |       |     |       | Geol.        |
| B.K.C. |       |     |       | Contr.       |
| Ce.    |       |     |       |              |
| C.     | 3485  |     |       | Co.          |
| M.     |       |     |       |              |
| M.     |       |     |       | Pool         |
| K.     |       |     |       |              |
| Mz.    |       |     |       | Heyt         |
| Mo.    |       |     |       |              |
| V.     |       |     |       |              |
| S.     |       |     |       |              |
| S.     |       |     |       |              |
| A.     | 3507  |     |       | COMPLETE     |
| R.     |       |     |       |              |
| Pe.    |       |     |       |              |
| G.     |       |     |       |              |
| Td.    | 3515  |     |       |              |

Date Comm. CART. F.O.

WORT AUG 8 '56 8-2-56 858

~~1163~~ 1163 1550. 2255

AUG 15 '56 DST 3509-15 1 hr run

30' OCIM BHP 980/30"

512 @ 3510/100 AUG 22 '56 CO 3515

15 Goph. holes 2 hrs 1 hr

8-54 1/2 130 + 240 wts 15 hrs

POP. AUG 29 '56 SEP 5 '56 SEP 12 '56 P. 37

B6 + 240 wts 24 hrs