


Ellis

KANSAS

SECTION 20 TOWNSHIP 114 RANGE 17 W

WELL NO. #1 Heyl

COMPANY Stearns Pet.

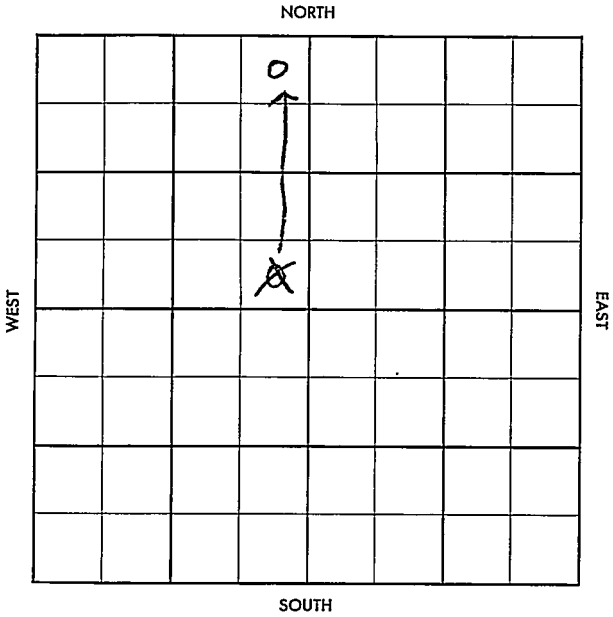

Ellis

KANSAS

SEC.	TWP.	R.
20	14	17 W

WELL NO.

1 Heyl

FARM

COMPANY

Stearns Pet. & Zeds Oil

CONTRACTOR

Co-Tools


Wildcat Heyl

Ft. from N. Line

Ft. from S. Line

Ft. from E. Line

Ft. from W. Line

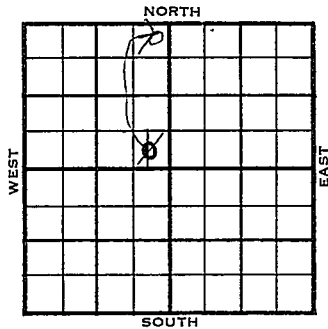NE NE
SE SE NWSDX - ~~1/4~~ Mile

Carter-DHM

	ELEVATION	REPORT
1955	1970'	
12/28	MIR	
1956		
1-6	Spud 12-28-55 8 5/8" @ 202/200 Heeb. 2930 Drlg. 3086	
1-12	Re-set 8 5/8" @ 311/800 DST 3271-77	
1-19	Top. 2930 Heeb. 3201 Lans. 3248 BKC 3471 Cong. 3491 Arb. 3511 TD 3520 DST 3271-77, op 1 hr. rec. 30' mw, 60# DST 3335-45, op 1 hr. rec. 15# wm, 900# DST 3513-20, op 1 hr. rec. 75' oil, 45' gas, 930# 5 1/2" @ 3511/75	
1-27	CO to 3520, B/ 2 boph, 120 MA, B/ 2 boph FU 750' oil 1 1/4 hr.	
2-2	P/ 45 bo 12 hrs .	

County EMMIS Elev. _____
 Sec. 20 Twp. (N41) Rgs. 17W
 Company Stearns Pet.
 Farm Name Hey1 No. 1

TOPS	DEPTH	LOG	DATUM
Anh.			
Tp.			
H.			
Tr.			
Dg.			
Bl.			
L.			
K.C.			
B.K.C.			
Ce.			
C.			
M.			
M.			
K.			
Mz.			
Me.			
V.			
S.			
S.			
A.			
R.			
Pe.			
G.			
T.D.			

Loc. in Sec. SE SE NW
 Geol. _____
 Contr. _____
 Pool Wildcat

DEC 28 '55
 0
 FIRST REPORT
 1/4 mile

Date Comm. Carter - DEM
M I R

Co.

Lse.

No.

Sec.

T.

R.

3510
1970
1/5

CORRECTION

FORM B13 REV. SUNRAY

 Sec. 20 Twp. 11N Rge. 17W
 Company Stearns Pet. 6 Paces to Dr. 4
 Farm Name Heyl No. 1

	TOPS	DEPTH	LOG	DATUM
Ant.				
Tp.		2830		
H.		3202	3201	
Tr.				
Dg.				
Bl.				
L.	✓	3249	3248	1278
K.C.				
R.C.			3471	1501
Co.				
C.			3491	1521
M.				
M.				
K.				
Mo.				
Mo.				
V.				
S.				
A.	3490	3490	3511	1541
R.				
PC.				
G.				
TD		3530		

Loc. in Sec. SE 22 NW
NE NE
 Geol. _____
 Contr. Co Tools
 Pool Heyl
Water

	0
1/2 mile	
FEB 22 1956	
1/2 mile	
COMPLETE	

Date Comm. Mag. F.O. Carter - DEM
MIR JUN 5 '56 12-28-55 8 5/8
400
~~1200~~ 1200 Ø 3086 JAN 18 '56 rec'd
8 5/8 311 1800 DST 3271-77
X app. 1 hr. rec. 30' MW BHP
60 DST 3335-45 1 hr. rec.
15' WM BHP 900 Ø 3425
~~1200~~ DST 3513-20 1 hr.
rec. 75' oil + 45' G. BHP 930
1 1/2 1 1/2 5 1/2 3511/75 MIST JUN 25 '56

CO 3528 FD 2 Baph nolw
120 gal Md acid FD 2 Baph
nolw grow 36° FU 750'
oil nolw 14 hrs FEB 1 58 P. 45
Bo nolw 12 hrs.

Fluid Level 2400' FEB 8 58 P. 70

Bo in 24 hrs nolw FEB 15 58 WPT

22

P 31 Bopd + Tr wts

R.G.

MAR 1 1956

COMPTON