
DX 78-1 1/2 Ellis KANSAS

Section 10 Township 14 Range 19W

Well No. 1 Weisner

Company Bankoff Oil

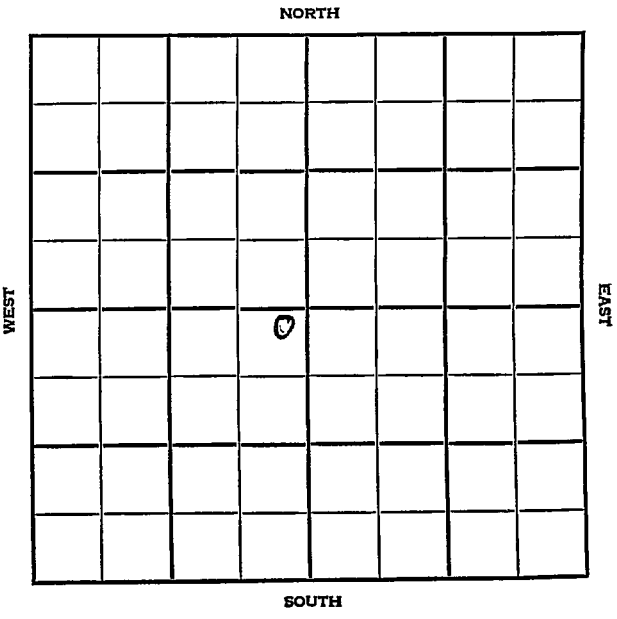

HOT FILE Ellis KANSAS

SEC.	TWP.	R.
10	14	19 W

WELL NO.

1 Weisner FARM


COMPANY

Bankoff Oil

CONTRACTOR

Anschutz

Wildcat

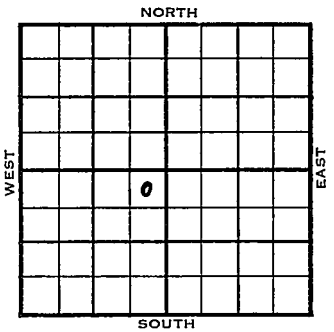

_____ Ft. from N. Line

_____ Ft. from S. Line

_____ Ft. from E. Line

_____ Ft. from W. Line

NE NE SW

1 Mile - SDX Gulf FO---Sun-DHM

1955' ELEVATION

	REPORT
6/22	Comm. 6-20-55 8" @ 288 w/150 WOC
6/30	Anhy 1515, Heeb. 3497, Tor. 3520, Lans. 3544, Drlg. 3682.
7/7	DST 3861-68 open 45 min. Rec. 10' mud 0# D&A

Tops:	Depth	Datum
Anh.	1515	
H.	3497	1277
Tr.	3520	1300
L.	3544	1324
BKC	3785	1565
C.	3833	1613
A.	3863	1643
TD:	3900	

ABANDONED

DX-78

FORM 513 REV. SUNRAY

County Ellis ✓ Elev.

Sec. 10 Twp. 14 ✓ Rge. 19W

Company Bankoff Oil

Farm Name Weisner No. 1


TOPS	DEPTH	LOG	DATUM
Anh.			
T.P.			
H.			
Tr.			
Dg.			
Bl.			
L.			
K.C.			
B.K.C.			
Ce.			
C.			
M.			
M.			
K.			
Mz.			
Mo.			
V.			
S.			
S.			
A			
R.			
P€.			
G.			
T.D.			

Loc. in Sec. NE NE SW

Geol.

Contr. Anschutz

Pool Wildcat

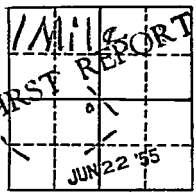

Date Comm. 6-20-55 Gulf FO Sun DRM

8" @ 288/150. WOC

K+LA

Co. Lse. No. Sec. T. R.

FORM 513 REV. SUNRAY

County Ellis Elev. 2220

Sec. 10 Twp. 14 Rge. 19W

Company Bankoff Oil

Farm Name Weisner No. 1


TOPS	DEPTH	LOG	DATUM
Anh.	1515		
Tp.			
H.	3497		1277
Tr.	3520		1300
Dg.			
B.L.			
L.	3544		1324
K.C.			
B.K.C.	3785		1565
Ce.			
C.	3833		1613
M.			
M.			
K.			
Mz.			
Mq.			
V.			
S.			
S.			
A	3863		1643
R.			
P€.			
G.			
T.D.	3900		

Loc. in Sec. NE NE SW

Geol.

Contr. Anschutz

Pool Wildcat

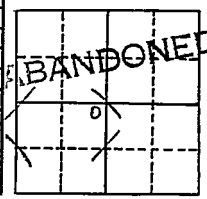

Date Comm. 6-20-55

JUL 6 1955

8" @ 288/150 DST 3861-68 open 45 min

Rec. 10' mud 0#

D & A

Co. Lse. No. Sec. T. R.