

Ellis

KANSAS

17

14S

17W

SECTION \_\_\_\_\_ TOWNSHIP \_\_\_\_\_ RANGE \_\_\_\_\_

#1 Jacob Stecklein


WELL NO. \_\_\_\_\_

COMPANY \_\_\_\_\_ Anschutz Drlg. Co. \_\_\_\_\_

NORTH

WEST

EAST

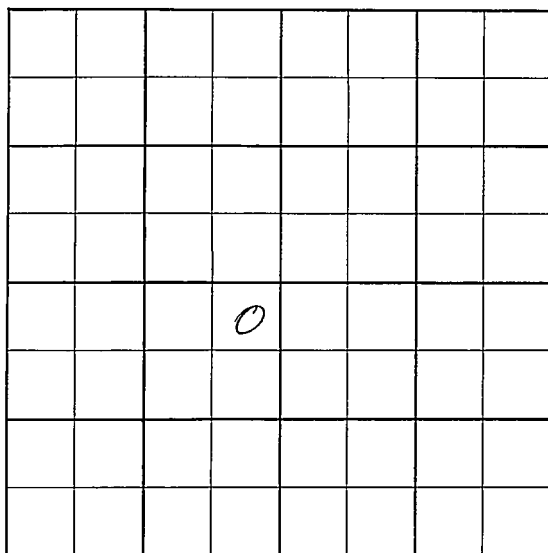

SOUTH

Date Comm. Sinclair-FO E $\frac{1}{2}$  SW $\frac{1}{4}$   
MIIT

629' c f 110

14

FORM 513 SUNRAY

County ELLIS Elev. 1979  
 Sec. 17 Twp. 11S Rge. 17W  
 Company Anschutz Ind. Co.  
 Farm Name Jacob Stre'lain No. 1

| TOPS | DEPTH | LOG  | DATUM | Loc. in Sec.          |
|------|-------|------|-------|-----------------------|
| Anh. |       |      |       | N <sup>W</sup> 1/4 SW |
| TP.  |       |      |       |                       |
| H.   | 3212  | 3213 |       |                       |
| Tr.  | 3231  | 3232 |       |                       |
| Dg.  |       |      |       |                       |
| Bl.  |       |      |       |                       |
| L.   | 3257  | 3260 |       | Geol.                 |
| K.C. |       |      |       | Contr.                |
| BKC. | 3481  | 3484 |       | Co.                   |
| Ce.  |       |      |       | Pool                  |
| C.   | 3496  | 3497 |       | Heyl                  |
| M.   |       |      |       |                       |
| M.   |       |      |       |                       |
| K.   |       |      |       |                       |
| Mz.  |       |      |       |                       |
| Mo.  |       |      |       |                       |
| V.   |       |      |       |                       |
| S.   |       |      |       |                       |
| S.   |       |      |       |                       |
| A    | 3530  | 3533 |       |                       |
| R.   |       |      |       |                       |
| PE.  |       |      |       |                       |
| G.   |       |      |       |                       |
| TD.  | 3558  |      |       |                       |

ABANDONED  
 NOV 7 '56

Date Comm. Sinclair-FO E<sup>1</sup> SW<sup>1</sup> SKelly DKNMIRT OCT 10 '56 10-2-56 8<sup>5</sup>/<sub>8</sub>

206/150 DST 3257-87 1hr

rec. 90' oil spkd Md 0-80

BHP 1150 @ 2hr22 OCT 17 '56

DST 3530-37 1hr 33' 0CM

BHP 630/20 DST 3535-44 1hr

65' HOCM BHP 880/30 DST

3544-58 1hr 190' V HOCM + 60'

Frothy Muddy oil 910/30" 5<sup>1</sup>/<sub>2</sub>@ 3556

OCT 24 '56

OCT 24 '56

NOV 7 '56

CO 3558  $\Phi$  28 ~~6wph~~ Goph  
 6 hrs 12/3550-52  $\Phi$  14  
 GO + 2 1/2 Gwph 50 gal acid  
 $\Phi$  18 Goph + 1 1/2 Gwph 5 hrs  
 1/4  $\Phi$  1.75 BFph 9 hrs  
 (50% wt) Bd p19 @ 3546  
 18/3542-45 1/2  $\Phi$  1.4 BFph  
 5 hrs (46% wt) PB 3538  
 12/3534-36  $\Phi$  1/2 Goph no/w  
 3 hrs 1/4  $\Phi$  1.75 BFph  
 7 hrs (46% w) To co. DEC 31 '56  
 SQ9 PFI5 NOV 1 '55 SQ ALL PFS  
 CO 3554 12/3550-52  $\Phi$   
 13 GF 1 hr 50% wt 1/2  $\Phi$   
 3 BFph 50% w 4 hrs PB  
 3546 18/3542-45  $\Phi$  5 GF  
 33% wt 2 hrs 12/3534-36  
 $\Phi$  6 GO + 1 GW 1 hr 1/4  $\Phi$  3  
 BFph 50% wt 5 hrs co  
 3558  $\Phi$  2.1 BFph 50% wt

DEA