

Butler

Form 51-5M-9-28-27423

Map No. KANSAS Sec. 35 Twp. 25 S R. 4E

Well No. 10-Deelen Beck, Farm
Sunclair Company

NORTH

WEST

EAST

							0

SOUTH

Location.....
 Drilling Remarks.....

Rig Up.....
 Drilling Remarks.....

RECORD

Cased..... in..... ft.
 Sand.....
 Gas.....
 Oil.....
 Total Depth.....

PRODUCTION

1st 24 hrs. Nat.....
 1st 24 hrs. after shot.....
 Gas..... cu. ft.....
 Dry Hole.....
 Abandoned.....

Map No. Sec. Twp. R.

Well No. Farm


..... Company

..... Ft. from N. Line

..... Ft. from S. Line

..... Ft. from E. Line

..... Ft. from W. Line

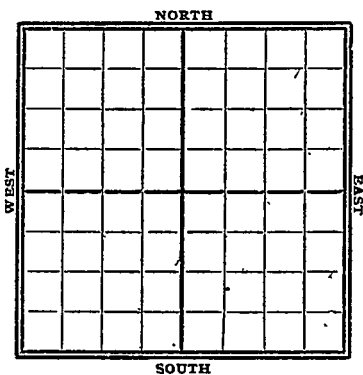

1917

Date

REPORT

Gypsy Records

7/3

Abel T.D 2451'

K14 MAP NO. KANSAS SEC. 35 TWP. 75S R. 4E

WELL NO. 10 Wellentech
Indisio. COMPANY

CONTRACTOR

SECTION PLAT

ABANDONED

_____ FT. FROM N. LINE

_____ FT. FROM S. LINE

_____ FT. FROM E. LINE

_____ FT. FROM W. LINE

			0

RECORD

LOCATION _____

CASED _____ IN. _____ FT.

RIG UP _____

SAND _____

DRILLING AND REMARKS:

GAS _____

OIL _____ ✓

TOTAL DEPTH 2421

PRODUCTION

1ST 24 HRS. NAT. _____

1ST 24 HRS. AFTER SHOT _____

GAS _____ CU. FT.

DRY HOLE _____ ✓

ABANDONED _____

DATE

7/3 1927

SCOUT