


Section 28 Township 14 Range 17W

Well No. #3 Herl

Company Lion Oil

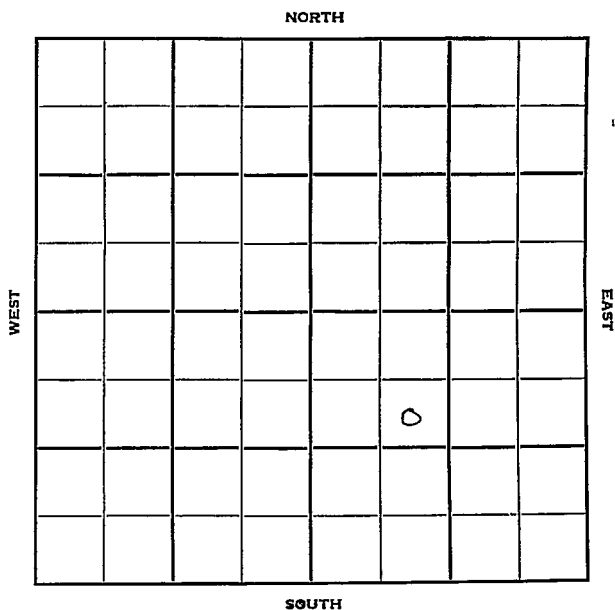

Ellis

KANSAS

Sec. 28 Twp. 14 R. 17W

Well No. #3 Herl Farm

Lion Oil Company

Contractor

Herl Pool


990' Ft. from N. Line

Ft. from S. Line

Ft. from E. Line

990' Ft. from W. Line

SE NW SE

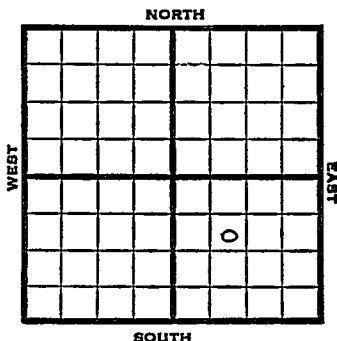


1951 Elev. 1960' REPORT

8/29 Location

11/7 Spud -
Oil Well TD 3510
9" @ 237'

Lans. 3223 Heeb. 3127
DST 3374-3403 open 1 hr.
Rec. 90' O&GCM 60 Ho&GCM
Cong. 3466 Arb. 3506-09
5" @ 3507 TD 3510 500 A
S/ 1 BOPH 1000 A S/ 2 $\frac{1}{4}$ BOPH
Comp 141 BOPD 6% wtr.

COMPLETED

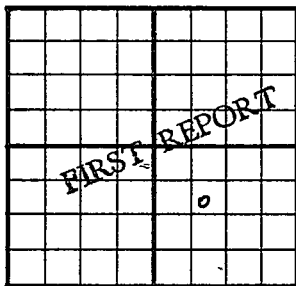County Ellis State KansasSec. 28 (Blk. Twp.) 14 (Sur. Rge.) 17W Map No.Operator Lion OilWell No. 3 Farm HerlElev. Location SE NW SE990 Ft. From N Line SE990 Ft. From W Line Quarter1st. Report AUG 29 1951

Completion

Remarks

Spudding Date

Drilg. Data Herl PoolLocation

