

WEST

EAST

SOUTH

Drilling Remarks

Drilling Remarks

RECORD

Sand.....

Gas.....

Oil_____

Total Depth.....

PRODUCTION

1st 24 hrs. Nat.

1st 24 hrs. after shot_____

Gas.....cu. ft.....

Dry Hole.....

Abandoned.....

Map No. Sec. Twp. R.

Well No. Farm


..... Company

..... Ft. from N. Line

..... Ft. from S. Line

..... Ft. from E. Line

..... Ft. from W. Line

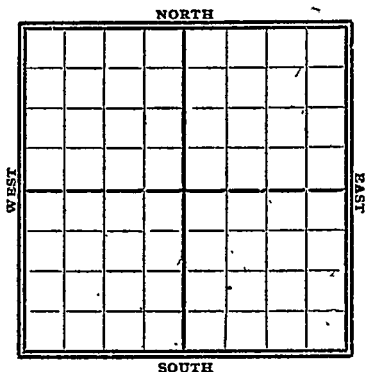

1917

Date

REPORT

Gypsy Records

4/15 Abd T.D 1231

Butler
 K14 MAP NO. KANSAS SEC. 35 TWP. 25S R. VE
 WELL NO. 8 Kullerbeck
Denclair COMPANY

CONTRACTOR

SECTION PLAT

ABANDONED

_____ FT. FROM N. LINE

_____ FT. FROM S. LINE

_____ FT. FROM E. LINE

_____ FT. FROM W. LINE

		0	

RECORD

LOCATION _____

CASED _____ IN. _____ FT.

RIG UP _____

SAND _____

DRILLING AND REMARKS:

GAS ✓

OIL _____

TOTAL DEPTH 1231

PRODUCTION

1ST 24 HRS. NAT. _____

1ST 24 HRS. AFTER SHOT _____

GAS _____ CU. FT.

DRY HOLE _____

ABANDONED ✓

DATE

4-15 1927 SCOUT