

Plotted
35-10-25E

WELL LOG BUREAU KANSAS GEOLOGICAL SOCIETY
UNION NATIONAL BAK BLDG, WICHITA, KANSAS

Location NW corner.


Sec 35 T. 10 R. 25E.

Aug 18 1930

County Wyandotte.

Casing Record.

10"	Farm	U. P.	No. 4
20" 8 1/4"	Company	Kansas City Industrial Land Co.	
15 1/2" 6 5/8"	Contr.		
12 1/2" 5 3/16"	Comm.	7/24/28.	Comp. 7/30/28.

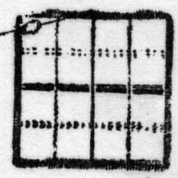

Total Depth. 455'. Shot Quarts Between
Correspondence Regarding This Well Should Be Referred To.

Elevation Est. 742

Figures Indicate Bottom of Formations
Date Issued 8/16/1930

Initial Production Dry.

Formation	Depth
soil	8
sand	40
coarse sand	53
shale	57
gravel	117
shale	191
sand little water	205
gr shale	210
red rock	217
lime	219
sand	227
shale	252
lime	263
gr shale	270
sdv shale	275
sand show oil	277
shale	287
lime	295
shale	298
sdv lime show oil & Gas	300
lime	305
shale	323
lime	327
shale little gas	345
shale	382
lime	385
shale	410
sand water	435
shale	445
lime	450
shale	455
Total Depth	455'

Log From Gas Well, The Kansas City Industrial Land Company,
Fairfax Industrial District, Kansas City, Kansas.

at R ✓

35-10-25E


620 f W Line
60 " N "

Well No. 4.

<u>Thickness of strata</u>	<u>Name of rock</u>	<u>Total depth</u>	
8'	Sandy soil	0' to 08'	
32'	Fine sand	08' " 40'	
13'	Coarse sand	40' " 53'	
4'	Blue mud	53' " 57'	
60'	Coarse sand and gravel	57' " 117'	Set 10" casing at 64'
74'	Dark shale	117' " 191'	Set 8 1/2" " " 117'
14'	Dark shale ? (sand?)	191' " 205'	Little water
5'	Green shale	205' " 210'	Should be so here
7'	Red shale	210' " 217'	# 191-202 ±
2'	Lime	217' " 219'	
8'	Light sand	219' " 227'	
25'	Light shale	227' " 252'	
11'	Gray lime	252' " 263'	
7'	Green shale	263' " 270'	
5'	Sandy shale	270' " 275'	
2'	Oil sand	275' " 277'	Showing of oil
10'	Dark shale	277' " 287'	
8'	Brown lime	287' " 295'	
3'	Light shale	295' " 298'	
2'	Light sandy lime	298' " 300'	Showing of oil and gas
5'	Dark lime	300' " 305'	Showing of oil
18'	Black shale	305' " 323'	
4'	Black lime	323' " 327'	
18'	Black shale & lignite	327' " 345'	Little gas
10'	Black shale	345' " 355'	
10'	Blue shale	355' " 365'	
17'	Light shale	365' " 382'	
3'	Black lime	382' " 385'	
25'	Dark shale	385' " 410'	
25'	Dark sand	410' " 435'	Water
10'	Black slate	435' " 445'	
5'	Gray lime	445' " 450'	
5'	Black slate	450' " 455' ✓	

745
323
420

..... Company
..... Farm
No. 35 Tp. 10 R. 25
Map No. Well No.

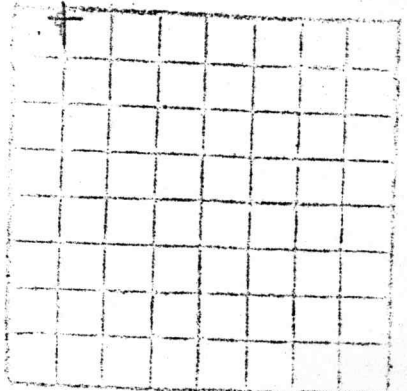

Location- Levee station 164 + 68- 180' Right

Elevation top of ground 331.4
413.5
744.9