


DX 78-1 Ellis

Section 25 Township T4 Range 17W

Well No. 1 Ruder

Company T. O. Lilystrand

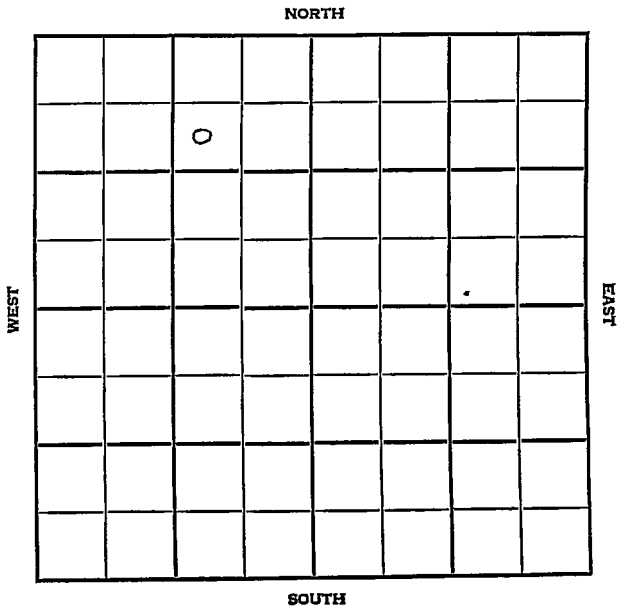

Ellis

KANSAS


SEC.	25	TWP.	14	R.	17W
------	----	------	----	----	-----

WELL NO. #1 Rudér FARM

COMPANY T.O. Lilystrand

CONTRACTOR Wildcat.

990 _____ Ft. from N. Line
 _____ Ft. from S. Line
 990 _____ Ft. from E. Line
 _____ Ft. from W. Line

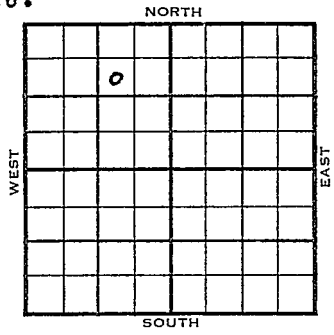

SW NE NW

1955 ELEVATION REPORT

4/27 MIR

County Ellis State Kansas

Sec. 25 (Blk. Twp.) 14 (Sur. Rge.) 17W Map No.

Operator T. O. Lilystrand

Well No. 1 Farm Ruder

Elev. _____ Location SW NE NW

	o				
FIRST REPORT					

990 Ft. From N Line NW

990 Ft. From E Line Quarter

1st. Report APR 27 1955

Completion _____

Remarks _____

Spudding Date _____

Drlg. Data Wildcat

M I R

K-14

FABEN GILSTRAP