


Section 12 Township 14 Range 19-W

Well Number #1 Weisner

Company Murphy Oil

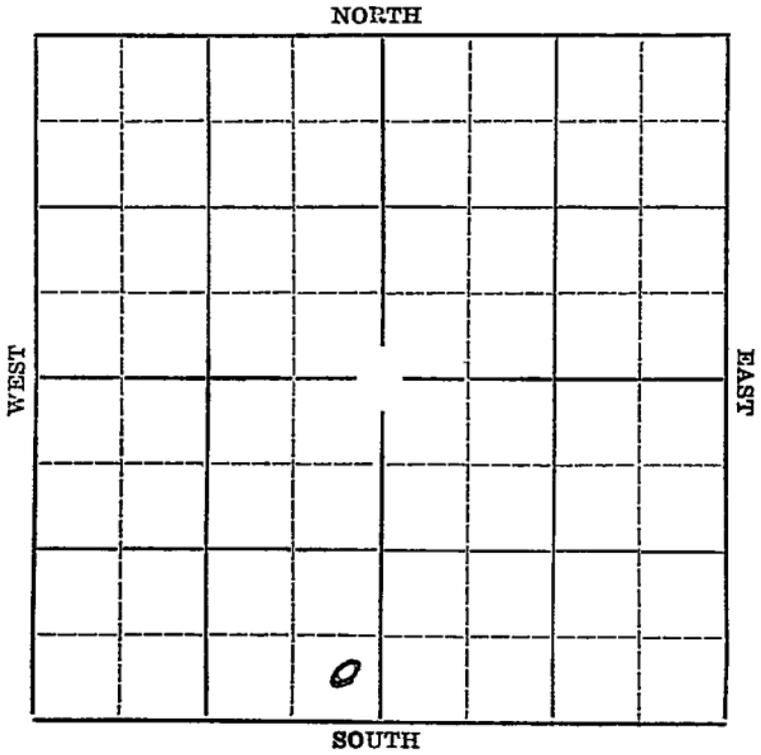

KANSAS

Map No. _____ Sec. 12 Twp. 14 R. 19W

Well No. #1 Garin Weisner Farm _____

Murphy Oil Company

SPECIAL


_____ Ft. from N. Line

330' Ft. from S. Line

_____ Ft. from E. Line

330' Ft. from W. Line

Elev. 2181

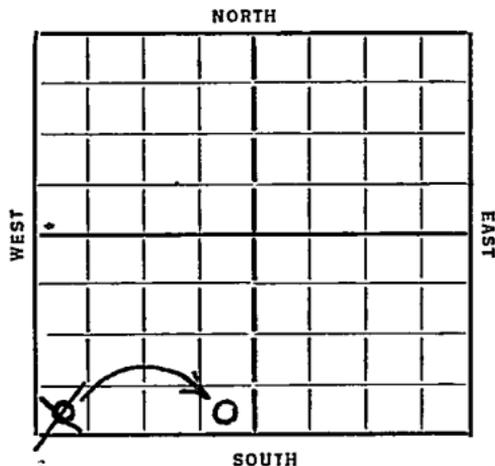

1936

REPORT

SPECIAL

7/15 Location

7/23-- 7/30-- 8/6-- 8/13--8/20--8/27--

9/3 Rigging up.

9/10--

9/18 Rigged up and shut down.

9/24 --10/1--10/8--

10/15-Spud.

10/22 Drlg. 565'.

10/29 600' shut down.

11/6 15" @ 600 Drlg.

11/12 Drlg. 720'.

11/19 Under Ream 15"

11/27 Drlg. 815'.

12/3 Fishing 815'.

12/10 Drlg. 960'.

12/17 1175' fishing.

12/24--- 12/29---

1937

1/7 12" @ 1196'. Drlg. 1320'.

1/14 Anhydrate 1440'. Underream 12"

1/21 12" @ 1448'. Drlg. 1740'.

OVER

Map No. 70 Sec. 12 Twp. 14 R. 19W

Well No. Heinrich

Murphy Oil Company

Contractor

SECTION PLAT

_____ Ft. from N. Line

330 Ft. from S. Line

330 Ft. from E. Line

_____ Ft. from W. Line

CORRECTION

Location _____

Rig up _____

Drilling and Remarks:

*Reported
OK and
Farm as herein*

RECORD

Cased _____ in., _____ ft.

Sand _____

Gas _____

Oil _____

Total Depth _____

PRODUCTION

1st 24 hrs. Nat. _____

1st 24 hrs. after shot _____

Gas _____ Cu. Ft.

Dry Hole _____

Abandoned _____

Date

JUL 22 1936 19

S. J. LEWIS Scout

Ellis

KANSAS

Map No. 70 Sec. 12 Twp. 14 R. 19^w

Well No. 1 - Weisner

Murphy Oil etal Company

Contractor

ABANDONED

SECTION PLAT

_____ Ft. from N. Line

330 Ft. from S. Line

330 Ft. from E. Line

_____ Ft. from W. Line

We purchased this well average on this well

Location _____

Rig up _____

Drilling and Remarks:

H. F. W.

DVA

RECORD

Cased _____ in., _____ ft.

Sand Sil 3829

Gas _____

Oil _____

Total Depth 3862

PRODUCTION

1st 24 hrs. Nat. _____

1st 24 hrs. after shot _____

Gas _____ Cu. Ft.

Dry Hole _____

Abandoned _____

Date

MAY 5 - 1937

19

H. D. Hagfield Scout

KANSAS

Map No. _____ Sec. 12 Twp. 14 R. 19W

Well No. 1 Union

Murphy Oil Company

Contractor

SECTION PLAT

0			

_____ Ft. from N. Line

330 Ft. from S. Line

_____ Ft. from E. Line

330 Ft. from W. Line

FIRST REPORT

Location ✓

Rig up _____

Drilling and Remarks:

RECORD

Cased _____ in., _____ ft.

Sand _____

Gas _____

Oil _____

Total Depth _____

PRODUCTION

1st 24 hrs. Nat. _____

1st 24 hrs. after shot _____

Gas _____ Cu. Ft.

Dry Hole _____

Abandoned _____

Date

JUL 15 1936 19

S. J. LEWIS

Scout

1937

1/28 Drlg. 2290'.

2/4 Drlg. 2410

2/11 10" @ 2426' T.D. 2667. Under ream
10"

2/19 10" @ 2690' Drlg. 2845

2/26 Drlg. 3000'

3/4 Topeka 3175'. TD 3185'. under-
ream 8".

3/11 8" @ 3185' Clean out.

3/18 8" @ 3177'

Topeka 3235' TD 3400'

Under ream 8"

3/25 Shut down.

4/2 Shut down 3470'.

4/8 " " "

4/16 Under ream 8"

4/21--Top Kansas City 3480 Smell oil
Dlg. 3683 Small show oil 3647

Running 3 feet lower than production to the
southwest.

4/30 Show oil 3645-47'.

Conglomerate 3750'.

Drlg. 3784'.

5/5 Sil. 3829'.

T.D. 3862'.

ABANDONED