


Section 4 Township 14 Range 17W

Well No. #1 Dreiling

Company Musgrove Pet.

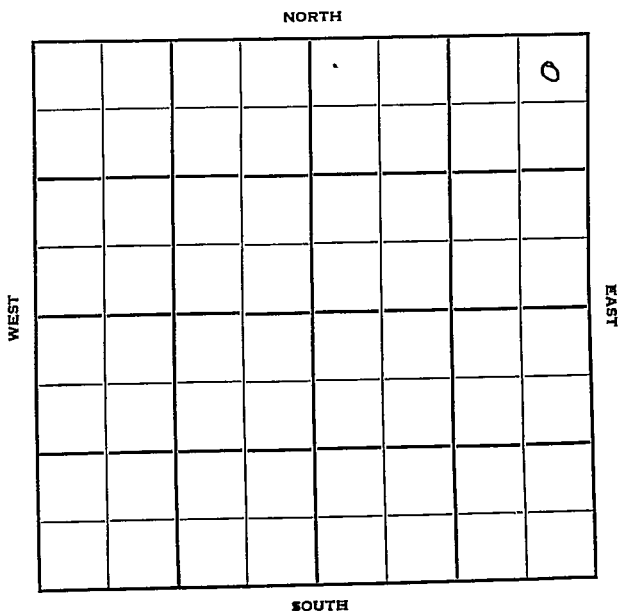

Ellis

Sec. 4 Twp. 14 R. 17W

Well No. #1 Dreiling Farm

Musgrove Pet.

Company

Contractor

Wildcat

330

Ft. from N. Line


Ft. from S. Line

330

Ft. from E. Line

Ft. from W. Line

NE NE NE

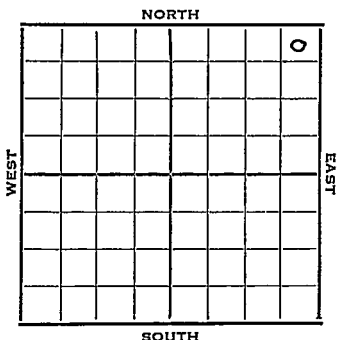

Sunray - DHM

1952 Elev. 1988'

REPORT

5/7 Spud 4-30-52
8" @ 228'
Anhy 835'
Drlg. 2380'

5/14 Spud 4-30-52
D&A TD 3679
8" @ 228 Anhy 835 Top 2979
Trans. 3284 Cong. 3529 Arb. 3665
TD 3679
D&A

ABANDONED

County **Ellis** State **Kansas**
 Sec. **4** (Blk. Twp.) **14** (Sur. Rge.) **17W** Map No.

Operator **Musgrove Pet.**

Well No. **1** Farm **Dreiling**

Elev. **1988** Location **NE NE NE**

330 Ft. From **N** Line **NE**

330 Ft. From **E** Line **Quarter**

1st. Report **MAY 7 1952**

Completion

Remarks **Sunray - IHM**

Spudding Date **4-30-52**

Drlg. Data **Wildcat**

8" © 228 Anhy 835 Drlg. 2380

J. G. McGEHEE



County Ellis State Kansas

Sec. 4 (Blk. 14 (Sur. 17W Map No.

Twp.) Rge.)

Operator Musgrove Pet.

Well No. 1 Farm Dreiling

Elev.	1988	Location	NE NE NE
-------	------	----------	----------

0

ABANDONED

330 Ft. From N Line NE

330 Ft. From E Line Quarter

Ist. Report

Completion MAY 14 1952

Remarks Wildcat

Spudding Date 4-30-52

Drlq. Data D & A TD 3679

8" @ 228 Anhy 835 Top. 2979

Lens. 3284 Cong. 3529 Arb. 3665

TD 3679

D & A

J. G. McGEHEE