

Map No. Sec. Twp. R.

Well No. Farm


..... Company

.....Ft. from N. Line

.....Ft. from S. Line

.....Ft. from E. Line

.....Ft. from W. Line

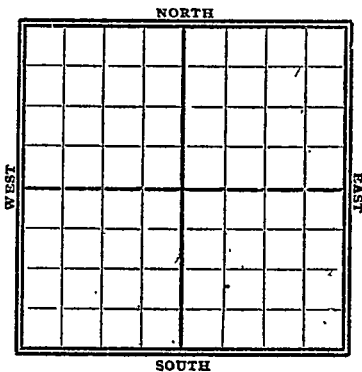

1927

Date

REPORT

Gypsy Records

7/11

Abd. T.P. 2417'

256 - 55

K14 MAP NO. KANSAS SEC. 38 TWP. 25S R. 4E

WELL NO. 12 Dulentic
Senclair COMPANY

CONTRACTOR

SECTION PLAT

ABANDONED

_____ FT. FROM N. LINE
_____ FT. FROM S. LINE
_____ FT. FROM E. LINE
_____ FT. FROM W. LINE

| | | | |
|--|--|---|--|
| | | | |
| | | | |
| | | | |
| | | 0 | |

RECORD

LOCATION _____

CASED _____ IN. _____ FT.

RIG UP _____


SAND _____

DRILLING AND REMARKS:

GAS _____

OIL _____

TOTAL DEPTH 2414

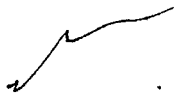

PRODUCTION

1ST 24 HRS. NAT. _____

1ST 24 HRS. AFTER SHOT _____

GAS _____ CU. FT.

DRY HOLE

ABANDONED

DATE

1-11 1927

SCOUT