


Section 28 Township 14 Range 17W

Well No. #1 Gross

Company Lion Oil

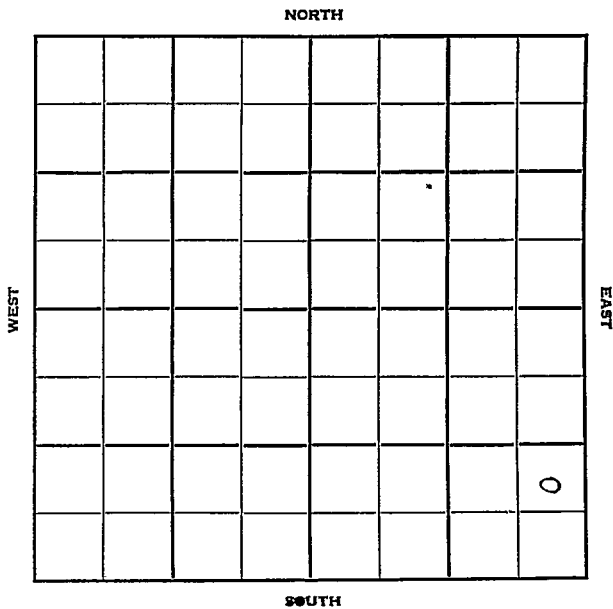

Ellis
14

KANSAS
17W

Sec. 28 Twp. R.

Well No. #1 Gross Farm

Lion Oil Company

Garvey Oil - Contr. Contractor

Herl Pool


Ft. from N. Line

990' Ft. from S. Line

330' Ft. from E. Line

Ft. from W. Line

NE SE SE

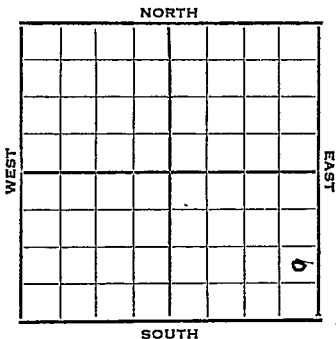

1951 Elev. 1947' REPORT

12/12 Location
1952
2/6 Spud 12-17-51
Oil Well TD 3481
8" @ 207
Heeb. 3161 Lans. 3209
DST 3356-90 open 45 min. rec. 60'
O&GCM Cong. 3447 Arb. 3473
TD 3475 5" @ 3474 DD 3476 500 A
S/ 1 goph DD 3481 1000 A S/ 5 1/2
BOPH Comp. 167 bopd

COMPLETED

