


DX 78-1

Section 28 Township 14 Range 17 W
Well No. #1 Leiker
Company Rex & Morris et al

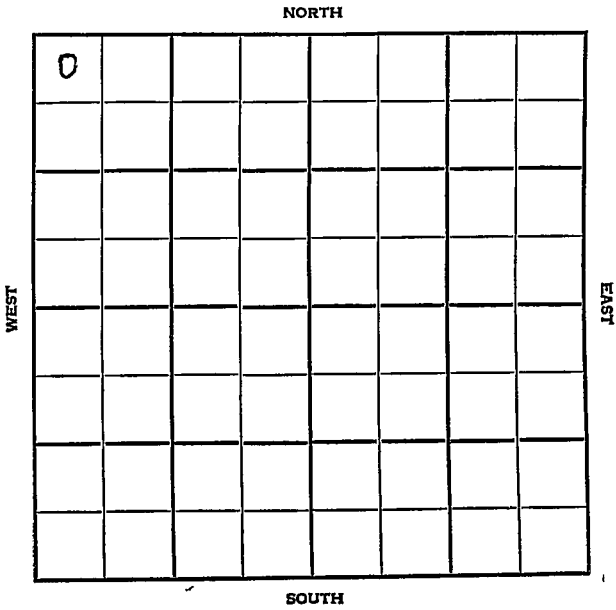

SEC. 28	TWP. 14 S	R. 17 W
------------	--------------	------------

WELL NO.

#1 Leiker

FARM

COMPANY

Rex & Morris Drilling Co. etal

CONTRACTOR

S-10003

Wildcat

NORTH

_____ Ft. from N. Line

0

_____ Ft. from S. Line

_____ Ft. from E. Line

WEST

EAST

_____ Ft. from W. Line

SOUTH

NW NW NW

SDX DHC \$2,500.00

Lse. (S-10003)

1956	ELEVATION 1954	REPORT (WH5-DC97)
1/24		Arbuckle test well @3550' To be commenced by Feb. 15, 1956 To be completed by March 15, 1956 (See DHC Ltr. 1-23-56)
2/15		Location (F.R. Tkt)
2/18		RURT & start drlg. today. Should set surface pipe tomorrow. (Card-Rex & Morris)
2/21		Spud 2-17-56 Set 1120' of 8-5/8" @/450 sks. WOC. Anhy. 1115' "
2/23		Drlg. 2100' "
3-1		Top 2970 Heeb. 3187 Tor. 3209 Lans. 3235 DST 3299-3322, op 1 hr. rec. 45' mud, 880#,
3		Cong. 3475 Drlg. 3510
3/7		Spud 2-17-56. 8-5/8" @ 1120 w/450 WOC. Arb. 3518' RTD 3560' Ran Log. Anh. 1115', TP. 2970', H 3187', Tr. 3209', L. 3235', C. 3475' A. 3518' TD 3560' D & A - Do not advise - Contract section

County Evlis Elev. _____
 Sec. 28 Twp. N Rge. 17W
 Company Rex & Morris et al.
 Farm Name Leiker No. 1

TOPS	DEPTH	LOG	DATUM	Loc. in Sec.
Anh.				NW NW NW
Tp.				
H.				
Tr.				
Dg.				
Bl.				
L.				Geol. _____
K.C.				Contr. _____
B.K.C.				
Ce.				
C.				
M.				Pool
M.				Wildcat
K.				
Mz.				
Mo.				
V.				
S.				
S.				
A.				
R.				
PE.				FIRST REPORT
G.				FEB 15 '55
T.D.				

Date Comm. Sunray Mid-Continent support
 Location _____

Co.
 Sec.
 No.
 T.
 R.

FORM 513 REV. SUNRAY

County Elvis Elev. 1954
 Sec. 28 Twp. M Rge. 17W
 Company Rex & Morris et al.
 Farm Name Leiker No. 1

TOPS	DEPTH	LOG	DATUM	Loc. in Sec.
As	1115			NW NW NW
Tp	2970			
H	3187			
Tr	3209			
D				
Bl				
L	3235		1281	Geol.
KC				Cont.
RKC				
C				
C	3475		1521	Pool
M				Wildcat
M				
K				
M				
V				
S				
S	3518		1564	<div style="border: 1px solid black; padding: 5px; text-align: center;"> <p>ABANDONED</p> <p>MAR 7 1956</p> </div>
A				
R				
P				
C				
JD	3560			

Date Comm. FEB 22 56 Sunray Mid. Continent support

Location spc 2-17-56
ps/p 1120/450 at woc @ 2000
DST 3299-3322 woc 1hr.
 By Pass Tool rec. 45' Md BHP
280 c9 3475 @ 3510 MAR 7 56
ask 3518 RTP 3560 Ran Log

HL E' A