


Section 29 Township 14 Range 17WWell No. #1 GrossCompany Brooks-Pierce

NORTH

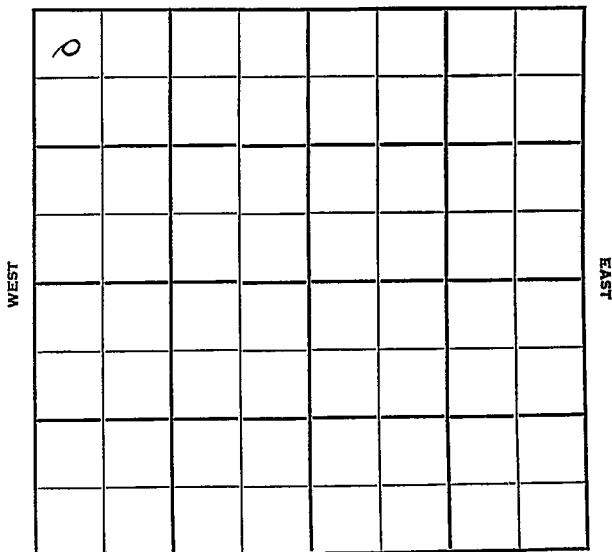

SOUTH

Sec. 29 Twp. 14 R. ✓ 17W

Well No. #1 Gross Farm

Brooks-Pierce Company


Wildcat Contractor

330' Ft. from N. Line

Ft. from S. Line

Ft. from E. Line

330' Ft. from W. Line

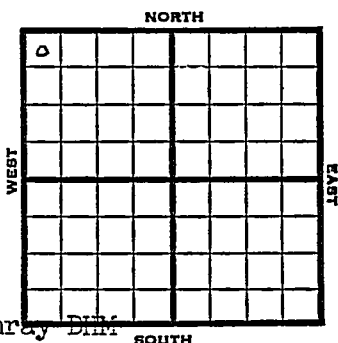

NW NW NW

Skelly, Stanolind & Sunray ~~DIH~~

1951

Elev. 1956' REPORT

4/11

Location

5/2

Spud 4-17-51

D & A TD 3573' 8" @ 267

Anhy 1140-85' Heeb 3198' Tor 3214

Lans 3243'

DST 3255-71 open $\frac{1}{2}$ hr. rec 15' mud

DST 3283-3320' open 1 hr. rec 310' SW

Cong 3489' Arb. 3545-73' TD

D & A

ABANDONED

County Ellis State KansasSec. 29 (Blk. Twp.) 14 (Sur. Rge.) 17W Map No.Operator Brooks - PierceWell No. 1 Farm GrossElev. Location NW NW NW

0							

330 Ft. From N Line NW330 Ft. From W Line Quarter1st. Report APR 11 1951


Completion

Remarks Skelly, Stanolind &Sunray DHM

Spudding Date

Drlg. Data WildcatLocation

J. E. TYRA

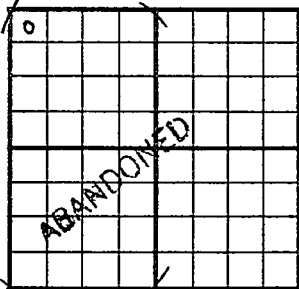County Ellis State KansasSec. 29 (Blk.
Twp.) 14 (Sur.
Rge.) 17W Map No.Operator Brooks - PierceWell No. 1 Farm GrossElev. 1956 Location NW NW NW330 Ft. From N Line NW330 Ft. From W Line Quarter

1st. Report

Completion MAY 2 1951Remarks WildcatSpudding Date 4-17-51Drilg. Data D & A TD 35738" @ 267 Anhy 1140-85 Heeb. 3198Tor. 3214 Lans. 3243 DST 3255-71open $\frac{1}{2}$ hr. Rec. 15' mud DST 3283-3320open 1 hr. Rec. 310' sw Cong. 3489Arb. 3545-73 TDD & A