


Section 31 Township 14 Range 17W

Well No. #1 Penney

Company Lewis Drlg.

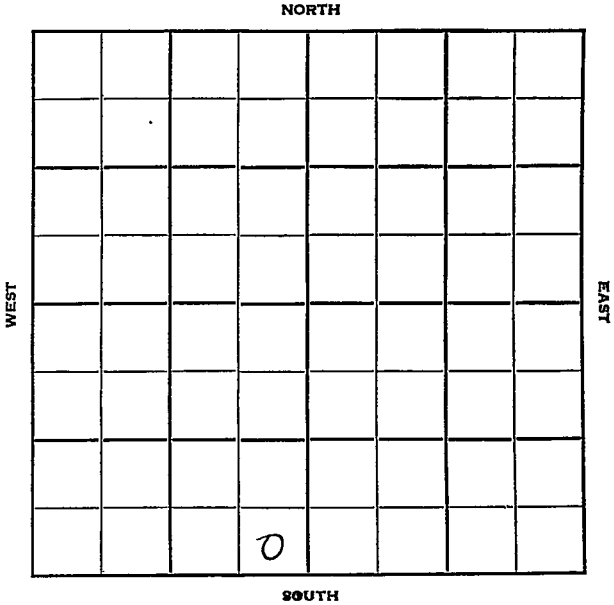

Sec. 31 Twp. 14 R. 17W ✓

Well No. #1 Penney Farm

Lewis Drlg. Company

Lewis Drlg. - Contr. Contractor

Wildcat


 Ft. from N. Line

330' Ft. from S. Line

330' Ft. from E. Line

 Ft. from W. Line

SE SE SW

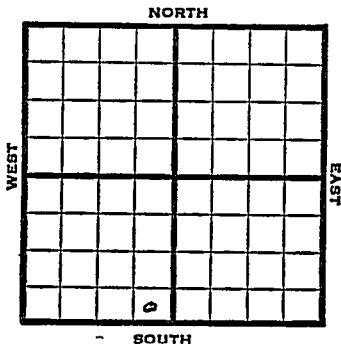

1950

Elev. 1974' REPORT

11/22

MIM

12/13

Spud 11-24-50

D&A TD 3664

8" @ 191

Anhy 1160-90

Top. 3003' Heeb. 3225'

Dodge 3246' Lans. 3271

Co g. 3574 Arb. 3643'

TD 3664'

D&A **ABANDONED**

