


Map No. A Sec. 31 Twp. 28 R. 6

Well No. 1 blank Farm

Van. Matre et al Company

NORTH

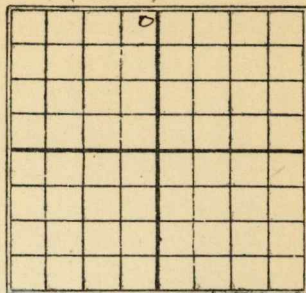

200 Ft. from N. Line

_____ Ft. from S. Line

200 Ft. from E. Line

_____ Ft. from W. Line

SOUTH

Date 1/22

REPORT

<u>1/27</u>	<u>Run 5 Logs</u>
<u>2/4</u>	<u>Spudding</u>
<u>3/30</u>	<u>Log 2650'</u>
<u>5/6</u>	<u>Dry & Abandoned 2905'</u>

Map No. K11 Sec. 31 Twp. 28 R. 6
 Well No. 1 - O Lak
Van-Matre et al. Company
 Contractor

FIRST REPORT

SECTION PLAT

200' Ft. from N. Line
 _____ Ft. from S. Line
200' Ft. from E. Line
 _____ Ft. from W. Line

Location _____

Rig up _____

Drilling and Remarks:

Right Foot

RECORD

Cased _____ in., _____ ft.
 Sand _____
 Gas _____
 Oil _____
 Total Depth _____

PRODUCTION

1st 24 hrs. Nat. _____
 1st 24 hrs. after shot _____
 Gas _____ Cu. Ft.
 Dry Hole _____
 Abandoned _____

Date

JAN 27 1922 ₁₉₁

M. A. BENEAR

Scout

Map No. R11 Sec. 31 Twp. 28 R. 6

Well No. 1 - Clark

Van Mate et al Company

Contractor

ABANDONED SECTION PLAT

200 Ft. from N. Line

Ft. from S. Line

200 Ft. from E. Line

Ft. from W. Line

COMPLETED

Location -----

Rig up -----

Drilling and Remarks:

20+9
2905

RECORD

Cased ----- in., ----- ft.

Sand -----

Gas -----

Oil -----

Total Depth -----

PRODUCTION

1st 24 hrs. Nat. -----

1st 24 hrs. after shot -----

Gas ----- Cu. Ft.

Dry Hole -----

Abandoned -----

Date **MAY** 6 1922

M. A. BENEAR

Scout