


Section 15 Township 14 Range 19W

Well No. 1 Kraus "B"

Company Bay Pet.

Kraus Pool
NORTH

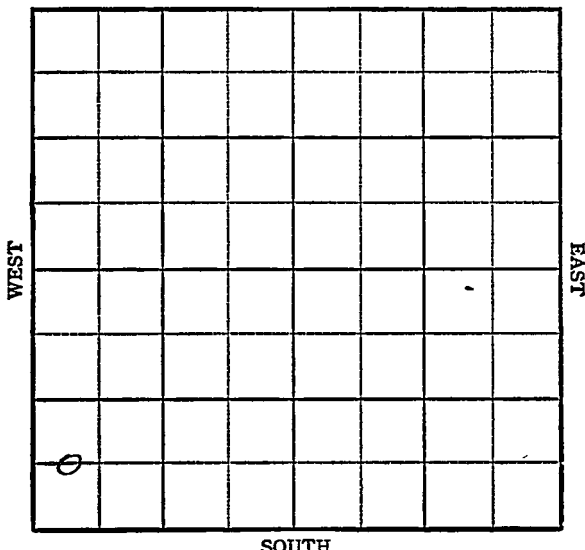

KANSAS Ellis

Sec. 15 Twp. 14 R. 19-W ✓

Well No. #1 Kraus "B" Farm

Bay Pet.

Company

Kraus


 Ft. from N. Line

660 Ft. from S. Line

 Ft. from E. Line

330 Ft. from W. Line

C W L SW SW

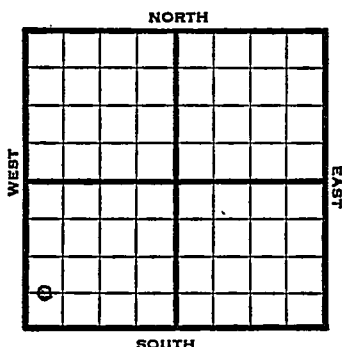

1948	Elev 2151' REPORT
12/22	Location
12/29	8" @ 250
	Drlg 1304'
1949	
1/12	TD 3817'
	Lansing 3453'
	Cong 3793'
	Arb 3799'
	Aband.
	ABANDONED

Map No. _____ Sec. 15 Twp. 14 R. 19W

Well No. 1 Kraus "B"

Bay Pet. _____ Company _____

FIRST REPORT

Contractor _____

C W L SW SW

SECTION FLAT

0			

_____ Ft. from N. Line

660 Ft. from S. Line

_____ Ft. from E. Line

330 Ft. from W. Line

Ellis County

RECORD

Location X

Cased _____ in., _____ ft.

Rig up _____

Sand _____

Drilling and Remarks:

Gas _____

Oil _____

Total Depth _____

PRODUCTION

1st 24 hrs. Nat. _____

1st 24 hrs. after shot _____

Gas _____ Cu. Ft.

Dry Hole _____

Abandoned _____

Date

DEC 22 1948 19

S. J. LEWIS Scout

~~KALUSS~~Map No. 70 Sec. 15 Twp. 14 R. 19WWell No. 1 Kraus "B"

Bay Pet. _____ Company _____

ABANDONED

Contractor _____

C W L SW SW

E, 2151
SECTION PLAT

_____ Ft. from N. Line

660 Ft. from S. Line

_____ Ft. from E. Line

330 Ft. from W. Line

0			

Ellis County

Location _____

Rig up _____

Drilling and Remarks:


RECORD

Cased _____ in., _____ ft.

Sand _____

Gas _____

Oil _____


PRODUCTION

1st 24 hrs. Nat. _____

1st 24 hrs. after shot _____

Gas _____ Cu. Ft.

Dry Hole _____

Abandoned _____

Date

JAN 1 2 1949 19

S. J. LEWIS Scout