

Map No. KANSAS Sec. 34 Twp. 14 R. 17^W
 Well No. 1 Brull Farm
Phillips Pet Company

NORTH

WEST

EAST

SOUTH

3

Location _____

Drilling Remarks _____

Rig Up _____

Drilling Remarks _____

RECORD

Cased _____ in. _____ ft.

Sand _____

Gas _____

Oil _____

Total Depth _____

PRODUCTION

1st 24 hrs. Nat. _____

1st 24 hrs. after shot _____

Gas _____ cu. ft.

Dry Hole _____

Abandoned _____


Map No. KANSAS Sec. 34 Twp. 14 R. 17 ^W
 Well No. 1 Bruehl Farm
Phillips Pet Company

1320 Ft. from N. Line

_____ Ft. from S. Line

_____ Ft. from E. Line

1320 Ft. from W. Line

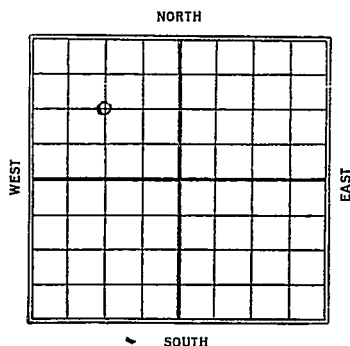

1928

Date	REPORT
9/12	Bldg Rig
9/19	Spud
9/26	_____
10/3	_____
10/10	_____
10/17	_____
10/24	_____
10/31	Spud & S.D
11/7	_____
11/14	_____
11/21	_____
11/28	Rigging up
12/5	_____
12/12	Spud 200'
12/19	ctrlg 550'
12/26	" 705'
1929	
1/2	" 1200'
1/9	" 1700'
1/16	" 2130'
1/23	" 2670'
1/30	" 3100'

2/6- Top Oswald 3287

drlg 3380'

2/13- UIR 6"- 3560' HFW

2/20

2/27- drlg 3644'

3/6 - " 3869'

3/13- Top Granite 3885'

T.D. 3895'

Dry & Abandoned


Eddie
 MAP NO. KANSAS SEC. 34 TWP. 14 R. 17W

WELL NO. 1820

Phillips P & S. COMPANY

CONTRACTOR

SECTION PLAT

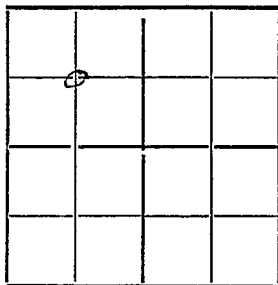

1820 FT. FROM N. LINE

FT. FROM S. LINE

FT. FROM E. LINE

1820 FT. FROM W. LINE

FIRST REPORTS

RECORD

LOCATION _____

CASED _____ IN. _____ FT.

RIG UP _____

SAND _____

DRILLING AND REMARKS:

GAS _____

OIL _____

TOTAL DEPTH _____

Building rig

PRODUCTION

1ST 24 HRS. NAT. _____

1ST 24 HRS. AFTER SHOT _____

GAS _____ CU. FT.

DRY HOLE _____

ABANDONED _____

DATE


SEP 12 1928 192 _____ SCOUT

Ellis
 Map No. **KANSAS** Sec. *34* Twp. *14* R. *12W*
Norman
 Well No. *1 Bull*

Phillips P & S Company
 Contractor

SECTION PLAT

1320 Ft. from N. Line
 _____ Ft. from S. Line
 _____ Ft. from E. Line
1320 Ft. from W. Line

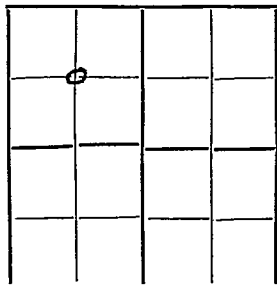

ABANDONED

Location _____

Rig up _____

Drilling and Remarks: _____

*Top Granite**3875**Total Depth**3895**J & A*

RECORD

Cased _____ in., _____ ft.

Sand _____

Gas _____

Oil _____

Total Depth *3895*

PRODUCTION

1st 24 hrs. Nat. _____

1st 24 hrs. after shot _____

Gas _____ Cu. Ft.

Dry Hole _____

Abandoned _____

Date

MAR 23 1929

S. J. LEWIS Scout