


Section 34 Township 28 Range 6 E

Well No. # 2 Mable Powers

Company K. T. Weidemann

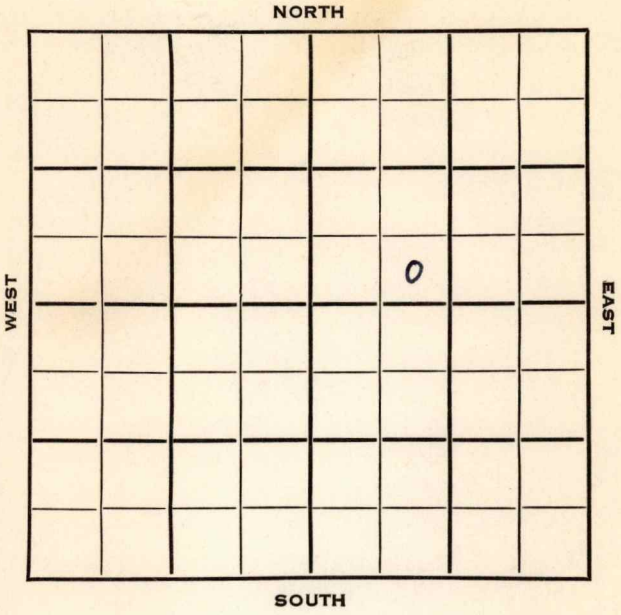



Sec. 34 Twp. 28 R. 6 E

Well No. # 2 Mable Powers Farm

K. T. Weidemann Company

Weidemann Contractor

Snowden-McSweeney


Ft. from N. Line

330 Ft. from S. Line

Ft. from E. Line

990 Ft. from W. Line

SE SW NE

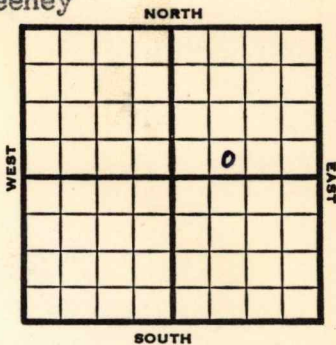

1953

Elev. 1420'

REPORT

6/10

Spud 5-27-53 10" @ 36
 KC 2126 DST in KC Miss 2876
 TD 2990 7" @ 2203

6/24

Spud 5-27-53
 Oil Well
 TD 2990
 10" @ 36
 KC 2126, Miss 2876
 TD 2990
 7" @ 2203
 CO to 2168
 40/2136-44
 Comp. 25 bopd

COMPLETED

