


Section 34 Township 28 Range 6 E

Well No. # 3 Mable Powers

Company K. T. Weidemann

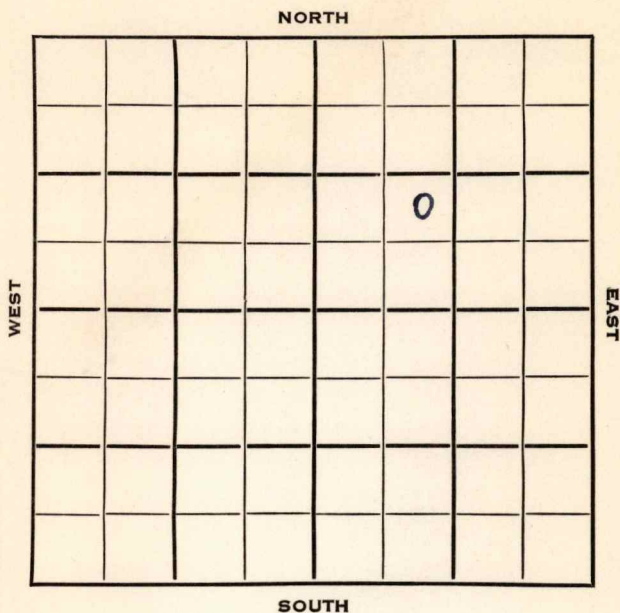

Sec. 34 Twp. 28 R. 6E

Well No. #3 Mable Powers Farm

K.T. Weidemann Company

Weidemann Contractor

Semisich Pool


_____ Ft. from N. Line

990 Ft. from S. Line

_____ Ft. from E. Line

990 Ft. from W. Line

NE SW NE

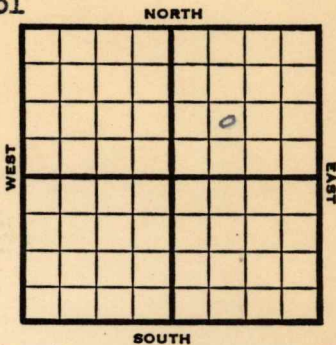

1953

Elev. 1419'

REPORT

8/26

Spud 8-19-53
10" @ 33'
Drlg 2050'

9/9

Spud 8-19-53
10" @ 33'
KC 2153', B KC 2367'
TD 2510'
D & A **ABANDONED**

