
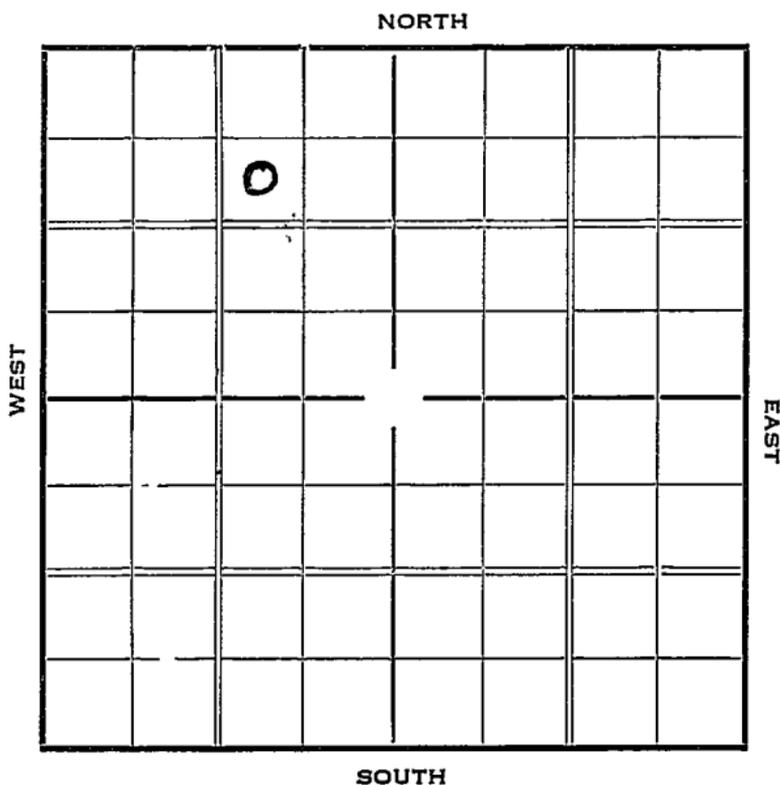


Section 17 Township 34 Range 3-E

Well Number 1 - Palmer

Company Empire

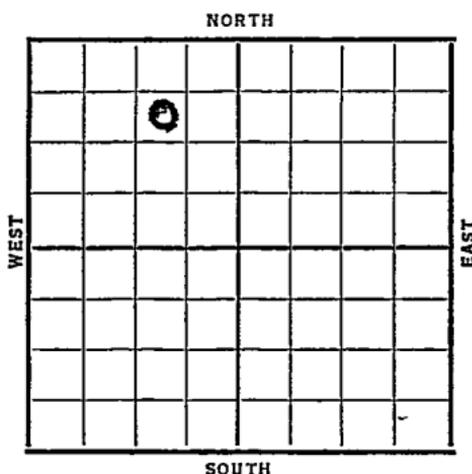

Sec. 17 Twp. 34 R. 3-EWell No. #1 Palmer FarmEmpire Company990 Ft. from N. Line     Ft. from S. Line990 Ft. from E. Line     Ft. from W. Line

Date	REPORT
1937	
5/5	Location
5/14	Rig
5/21	"
5/28	20" @ 90'. Drlg. 415'.
6/4	Drlg. 1100'.
6/11	15" @ 669'. 12" @ 1490'. Drlg. 1730'.
6/19	Drlg. 1950'. 3 M gas.
6/25	Drlg. 2285'.
7/2	T.D. 2470' C.O.
7/9	8" @ 2430'. T.D. 2785' H.F.W. Layton 2615'.
7/16	TD 2816' SD.
7/23	8" @ 2817'. Drlg. 3015'.
7/30	Chat 3344'. 200,000 gas @ 3361'. Sm. S.O. 3361-67'. T.D. 3382'. 1000' water. S.D.O.
8/4	Chat 3344' TD 3390' D&A
	ABANDONED

*Cowley* **KANSAS**

Map No. 1 Sec. 17 Twp. 34 R. 3<sup>E</sup>

Well No. 1 - Palmer

Empire Company  
Contractor

**FIRST REPORT**

**SECTION PLAT**

990 Ft. from N. Line

\_\_\_\_\_ Ft. from S. Line

990 Ft. from E. Line

\_\_\_\_\_ Ft. from W. Line

	0		

Location ✓

Rig up \_\_\_\_\_

Drilling and Remarks:

**RECORD**

Cased \_\_\_\_\_ in., \_\_\_\_\_ ft.

Sand \_\_\_\_\_

Gas \_\_\_\_\_

Oil \_\_\_\_\_

Total Depth \_\_\_\_\_

**PRODUCTION**

1st 24 hrs. Nat. \_\_\_\_\_

1st 24 hrs. after shot \_\_\_\_\_

Gas \_\_\_\_\_ Cu. Ft.

Dry Hole \_\_\_\_\_

Abandoned \_\_\_\_\_

Date

**MAY 5 - 1937**

19

*H. Hatfield* Scout

Cowley KANSASMap No. 1 Sec. 17 Twp. 34 R. 3 <sup>E</sup>Well No. 1 - PalmerEmpire Company

Contractor

ABANDONED

## SECTION PLAT

	o		

990 Ft. from N. Line

\_\_\_\_\_ Ft. from S. Line

990 Ft. from E. Line

\_\_\_\_\_ Ft. from W. Line

Location \_\_\_\_\_

Rig up \_\_\_\_\_

Drilling and Remarks:

DVA

## RECORD

Cased \_\_\_\_\_ in., \_\_\_\_\_ ft.

Sand CHAT 3344

Gas \_\_\_\_\_

Oil \_\_\_\_\_

Total Depth 3390

## PRODUCTION

1st 24 hrs. Nat. \_\_\_\_\_

1st 24 hrs. after shot \_\_\_\_\_

Gas \_\_\_\_\_ Cu. Ft.

Dry Hole \_\_\_\_\_

Abandoned \_\_\_\_\_

Date

AUG 1 - 1937H. D. Hatfield Scout