


KANSAS

SECTION 16 TOWNSHIP 14S RANGE 19W

WELL NO. #2 Kinderknecht

COMPANY Frontier Drlg.

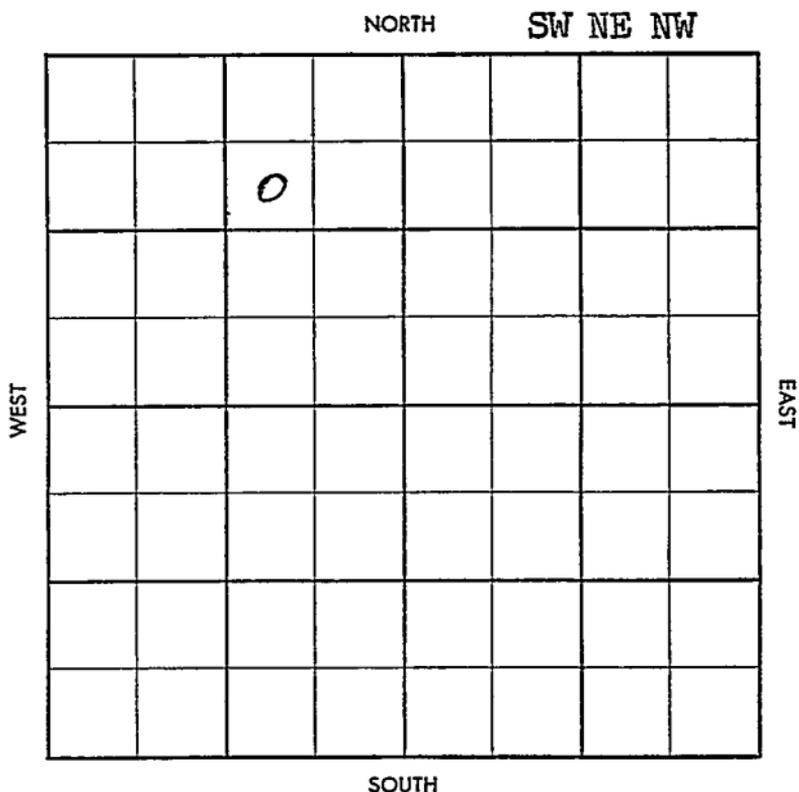

~~Top~~ Pool **KRAUS**
~~Bottom~~ ~~Flow~~

S-513-B.

County Ellis Elev. 2187 DF
 Sec. 16 Twp. 14 Rge. 1 9W 2190RB
 Company Frontier Drlg.
 Farm Name Kinderknecht No. 2

TOPS	DEPTH	LOG.	DATUM
Anh.	1165		
Tp.			
H.	3440		
Tr.			
Dg.			
B.L.			
L.	3487		
K.C.			
B.K.C.			
Ce.			
C.			
M.			
M.			
K.			
Mz.			
Mq.			
V.			
S.			
S.			
A.	3807		
R.			
Pf.			
G.			
TD.	3870		

Loc. in Sec. SW NE NW
 Geol. _____
 Contr. Red Tiger
 Pool N. Kraus
 COMPLETE
 JUL 23 '58

Date Comm. 5-10-58
8" @ 198 drlg. 2510 MAY 21 '58 DST 3809
20 2hrs 427' dip 1433' oil NW
B.H. 1190h. 4 1/2 3870 MAY 29 '58 CO
JUN 3 '58 Co 3840 (?) 3812-15 Lots w
50 50 JUN 11 '58 3812-15 200A
9 Bopk NW 6 hrs topop JUN 18 '58
JUN 25 '58 JUL 2 '58 JUL 9 '58 JUL 16 '58 JUL 23 '58
Phy P 120 Bopk NW 36' 9w
and 3812-15 TD 3870
PB 3840.

~~Frontier Drilling~~
~~Frontier Drilling~~

County Ellis Elev. 2187
 Sec. 16 Twp. 14 Rge. 19W
 Company Frontier Drlg.
 Farm Name Kinderknecht No. 2

TOPS	DEPTH	LOG	DATUM
Anh.	<u>1465</u>		
Tp.			
H.			
Tr.			
Dg.			
B.L.			
L.			
K.C.			
B.K.C.			
Ce.			
C.			
M.			
M.			
K.			
Mz.			
Mq.			
V.			
S.			
S.			
A.			
R.			
Pf.			
G.			
T.D.			

Loc. in Sec. _____


SW NE NW

Geol. _____

Contr. _____

Red Tiger

Pool _____

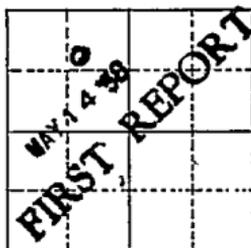N. Kraus

Date Comm. 5-10-58
8" @ 198 drlg. 2510

Co.

Lse.

No.

Sec.

T.

R.