


Section 31 Township 13 Range 20 W

Well No. #3 W. A. Nicholson

Company Texas Co.

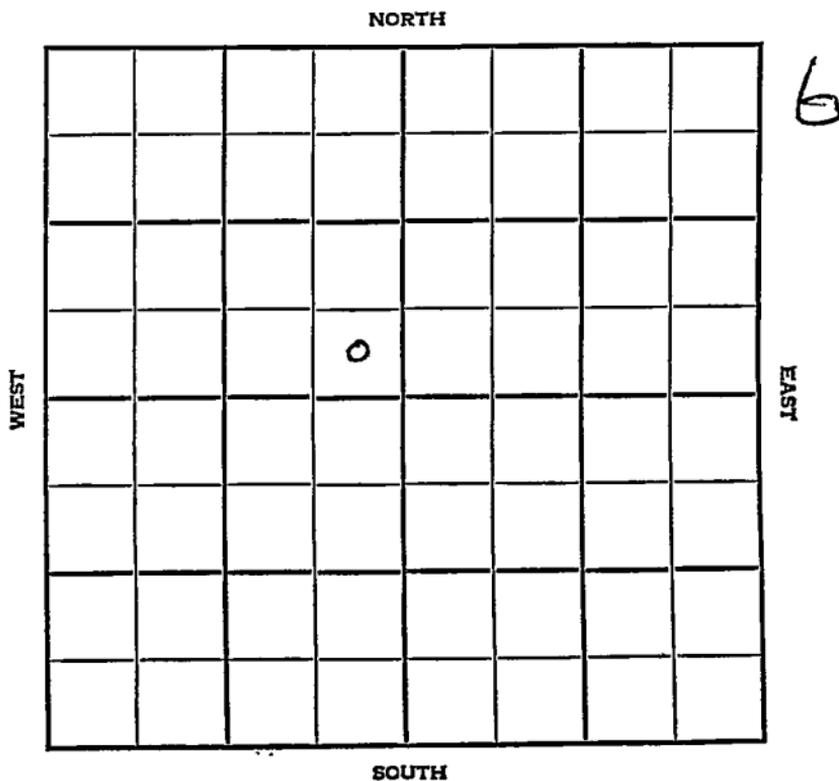

SEC.	TWP	R.
34	13	20W

WELL NO. #3 W. A. Nicholson FARM

COMPANY Texas Co.

CONTRACTOR Powell


NW Pleasant

\_\_\_\_\_ Ft. from N. Line

\_\_\_\_\_ Ft. from S. Line

\_\_\_\_\_ Ft. from E. Line

\_\_\_\_\_ Ft. from W. Line

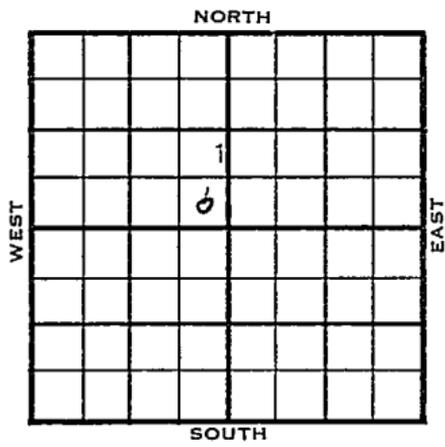

SE SE NW

1955	ELEVATION 2247'	REPORT
------	--------------------	--------

8/17 Comm 8-12-55  
10" @ 277/170  
Drlg 2530

9-7 DST 3858-64, open 1 hr., rec 45' ocm  
1140/20"  
7" @ 3863  
CO to 3866  
S/ 12 $\frac{1}{2}$  bo 2  $\frac{3}{4}$  bw 12 hr. 300 A  
S/ 12 $\frac{1}{4}$  bo 2 $\frac{1}{4}$  bw 9 hr.  
P/ 60 bo 111 bw 8 hr.  
Comp. 180 bopd 331 bw

<u>TOPS</u>	<u>DEPTH</u>	<u>LOG</u>
Anh.		1542
Tp.	3225	3228
H.		3474
Tr.	3497	1250
L.	3513	3514
<del>Max</del> arm	a	3811
Cong		3837
A	3859	3863
T.D.	3866'	

COMPLETED

County Edwards Elev. \_\_\_\_\_  
 Sec. 34 Twp. 13 Rge. 20W  
 Company Texas Company  
 FarmName W. A. Nicholson No. 3

TOPS	DEPTH	LOG	DATUM
Anh.			
Tp.			
H.			
Tr.			
Dg.			
Bl.			
L.			
K.C.			
B.K.C.			
Ce.			
C.			
M.			
M.			
K.			
Mz.			
Ma.			
V.			
S.			
S.			
A.			
R.			
PE.			
G.			
T.D.			

Loc. in Sec. SE SE NW  
 Geol. \_\_\_\_\_  
 Contr. Powerl  
 Pool NW Pleasant  
 AUG 17 '55  
 FIRST REPORT

Date Comm. 8-12-55  
10" @ 277/170 drlg. 2530

*[Handwritten signature]*

Co.  
L. Sec.  
Co.  
Sec.  
T.  
R.

County Ellis Elev. 2247  
 Sec. 31 Twp. 13 Rgs. 20W  
 Company Texas Company  
 FarmName W. A. Nicholson No. 3

TOPS	DEPTH	LOG	DATUM	Loc. in Sec.
Anh.		1542		SE SE NW
Tp.	3225	3228	981	
H.		3474	1227	
Tr.		3497	1250	
Dg.				
Bl.				
L.	3513	3514	1267	Geol.
K.C.				Contr.
B.K.C.				
Ce.				
C.				Powell
M. <i>arm</i>		3811	1564	Pool
M. <i>cong</i>		3837	1590	
K.				NW Pleasant
Mz.				
Me.				
V.				
S.				
S.				
A.	3859	3863	1616	
R.				
PE.				
G.				
T.D.	3866			



Date Comm. 8-12-55 SEP 7 1955  
 10" @ 277/170 DST 3858-64 open 1 hr.  
 Rec. 15' ocm 1110/20" 7" @ 3863  
 CO to 3866 S/ 12 1/2 bo 2 3/4 bw 12 hr.  
 300 A S/ 12 1/4 bo 2 1/4 bw 9 hr.  
 P/ 60 bo 111 bw 8 hr.  
 Comp. 180 bopd 331 bw