

Section 27 Township 13 Range 20 WWell No. # 1 KarlinCompany Imperial Pet.

		0						

NORTH

WEST

EAST

SOUTH

11

Ellis

KANSAS ✓

Sec. 27 Twp. 13 R. 20W

Well No. #1 Karlin Farm

Imperial Petr. Company

Imperial Contractor

330 NW Pleasant Pool


Ft. from N. Line

Ft. from S. Line

990 Ft. from E. Line

Ft. from W. Line

NW NE SW

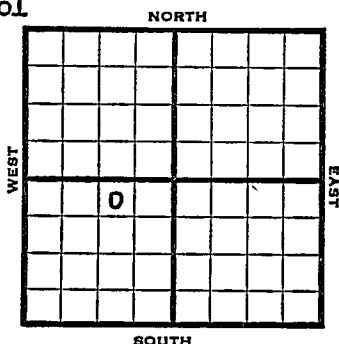

1953 Elev. 2228' REPORT

5/20 Spud 5-13-53
8" @ 227
Drlg. 2950

5/28 Heeb 3462, Lans 3501, Marm 3804, Cong 3830, Arb 3846
DST 3847-53 1 hr. 405' gas, 330' oil 930#
TD 7853
5" @ 3848'

6/3 CO 3853 S/-2 $\frac{1}{4}$ boph 24 hrs. 2000 A

6/10 S/ 3 boph

6/24 No report

7/1 Spud 5-13-53 Oil well TD 3853
8" @ 227 Heeb 3462 Lans 3501
Marm 3804' Cong 3830 Arb. 3846
DST 3847-53 open 1 hr rec 405' gas 330' oil 930# TD 3853 5" @ 3848
CO to 3853 S/2 $\frac{1}{2}$ BOPH 5000 A
S/3 BOPH
Comp. 238 BOPD 5% wtr.

COMPLETED

County **Ellis** State **Kansas**

Sec. 27 (Blk. Twp.) 13 (Sur. Rge.) 20W Map No.

Operator Imperial Pet.

Well No. 1 Farm Karlin

Elev.	Location	NW	NE	SE
-------	----------	----	----	----

[illegible]

330 Ft. From N Line SW

990 Ft. From E Line Quarter

1st. Report MAY 20 1953

Completion


Remarks

Imperial - Contr.

Spudding Date **5-13-53**

Drlg. Data NW Pleasant Pool

8th @ 227 drlg. 2950

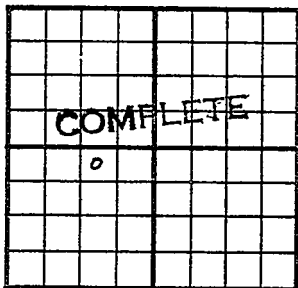County Ellis State KansasSec. 27 (Blk.
Twp.) 13 (Sur.
Rge.) 20W Map No.Operator Imperial Pet.Well No. 1 Farm KarlinElev. 2228 Location NW NE SW330 Ft. From N Line SW990 Ft. From E Line Quarter

1st. Report

Completion JUL. 1 1953Remarks NW Pleasant PoolImperial - Contr.Spudding Date 5-13-53Drlg. Data Oil well TD 38538" @ 227 Heeb. 3462 Lans. 3501Marm. 3804 Cong. 3830 Arb. 3846DST 3847-53 open 1 hr. Rec. 405' gas330' oil 930# TD 3853 5" @ 3848CO to 3853 S/ $2\frac{1}{2}$ boph 5000 AS/ 3 boph Comp. 238 bopd 5% wtr.

J. G. McGEHEE