


Section 34 Township 28 Range 6E

Well No. #3 Smith

Company Rex & Morris

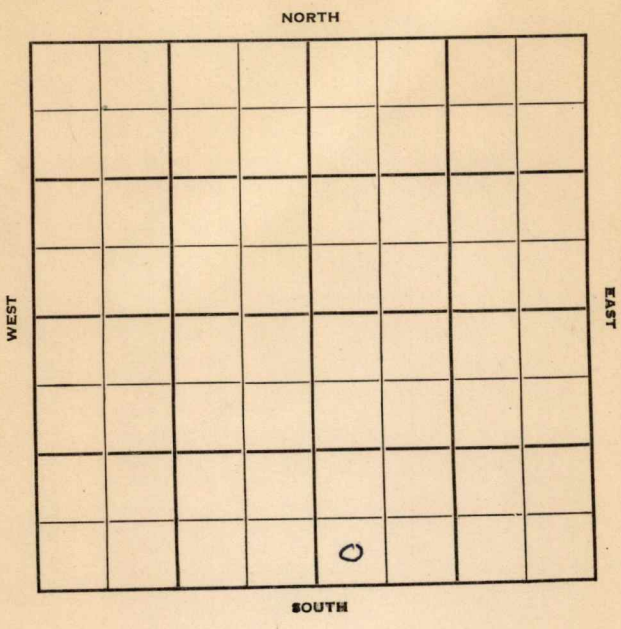

Butler

KANSAS ✓

Sec. 34 Twp. 28 R. 6E

Well No. #3 Smith Farm

Rex & Morris Company

Contractor


Ft. from N. Line

330 Ft. from S. Line

Ft. from E. Line

330 Ft. from W. Line

SW SW SE

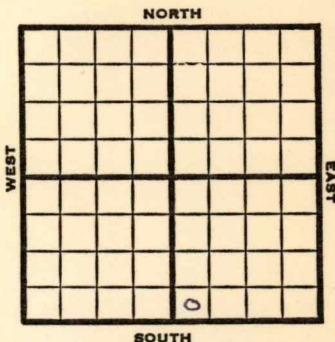

1952 Elev. 1434' REPORT

10/15 Cellar & Pits
 11/5 Spud 10-15-52
 OilWell TD 2832'
 8" @ 152
Bart. 2793
 TD 2795 5" @ 2795 DD 2832
 Hydro. F/ 20 boph
 Comp. 25 bopd

COMPLETED

