


Butler **KANSAS**

Section 34 Township 28 Range 6E

Well No. #6 Smith

Company Rex & Morris

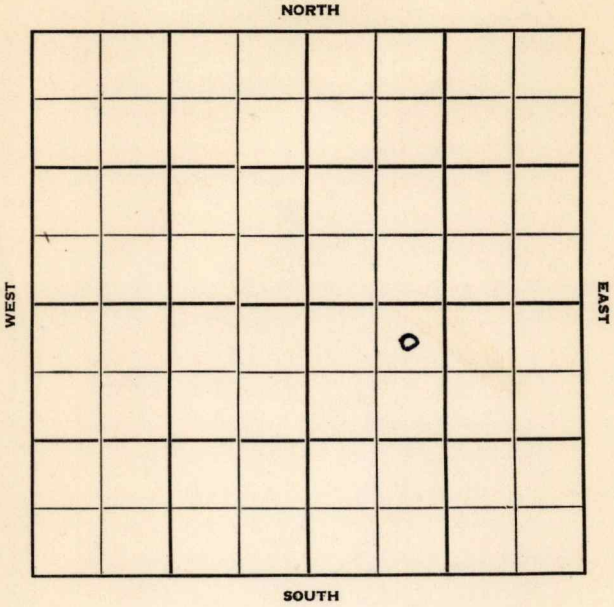

Sec. 34 Twp. 28 R. 6E

Well No. #6 Smith Farm

Rex & Morris Company

Contractor


330 Ft. from N. Line

_____ Ft. from S. Line

_____ Ft. from E. Line

990 Ft. from W. Line

NE NW SE

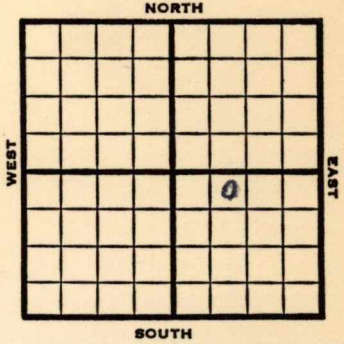

1953

Elev. 1421' REPORT

7/1

Location

9/23

D & A TD 2847 8" @ 94
Lans 1750 KC 2160
 DST 2164-84 open 1 hr rec 230' HO
 & GCM, 200# **Miss 2837**
 TD 2847 5" @ 2297 6/2166-68
 24/2176-84 HFW D & A

ABANDONED

