

Sec. 34 Twp. 28 Range 6E

1 A.D. Smith & R.K. Casper

Kansas Geological Society

Snowden & McSweeney

Skelly Scout Tickets

Map No. K Sec. 34 Twp. 28 R. 6

Well No. 19 H. Smith, Billy
Snowden & M^cLeary Company


NORTH

_____ Ft. from N. Line

200 Ft. from S. Line

200 Ft. from E. Line

_____ Ft. from W. Line

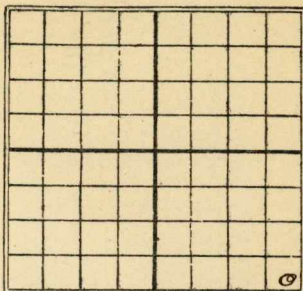

SOUTH

Date 1/27

REPORT

<u>1/27</u>	<u>Rig</u>
<u>2/4</u>	<u>Rig & Tools</u>
<u>3/30</u>	<u>Dig 1200'</u>
<u>7/5</u>	<u>2848-74 TD 2876</u>
	<u>50 Bbls Oil & same water</u>

Map No. K11 Sec. 34 Twp. 28 R. 6Well No. 1-G.D. Smith & R.K. CooperSnowden & McDweeney Company

Contractor

FIRST REPORT**SECTION PLAT**

----- Ft. from N. Line

200' Ft. from S. Line200' Ft. from E. Line

----- Ft. from W. Line

Location -----

Rig up -----

Drilling and Remarks:

Rig**RECORD**

Cased ----- in., ----- ft.

Sand -----

Gas -----

Oil -----

Total Depth -----

PRODUCTION

1st 24 hrs. Nat. -----

1st 24 hrs. after shot -----

Gas ----- Cu. Ft.

Dry Hole -----

Abandoned -----

Date

JAN 27 1922

191

M. A. BENEAR

Scout

Map No. *Sec. 34* Twp. *29* R. *6*Well No. *19th Smith & R.K. Cooper**Snowden & M. Sweeney* Company

Contractor

COMPLETED**SECTION PLAT**

Ft. from N. Line

200' Ft. from S. Line*200'* Ft. from E. Line

Ft. from W. Line

Location

Rig up

Drilling and Remarks:

*50 fbb oil
& some
water***RECORD**

Cased _____ in., _____ ft.

Sand _____

Gas _____

Oil *2848-74*Total Depth *2876***PRODUCTION**

1st 24 hrs. Nat. _____

1st 24 hrs. after shot _____

Gas _____ Cu. Ft.

Dry Hole _____

Abandoned _____

Date

*JUL 15 1922**M. A. BENEAR**191*

Scout