


Section 17 Township 34 Range 3E

Well No. #2 M. O. Palmer

Company Oquinn

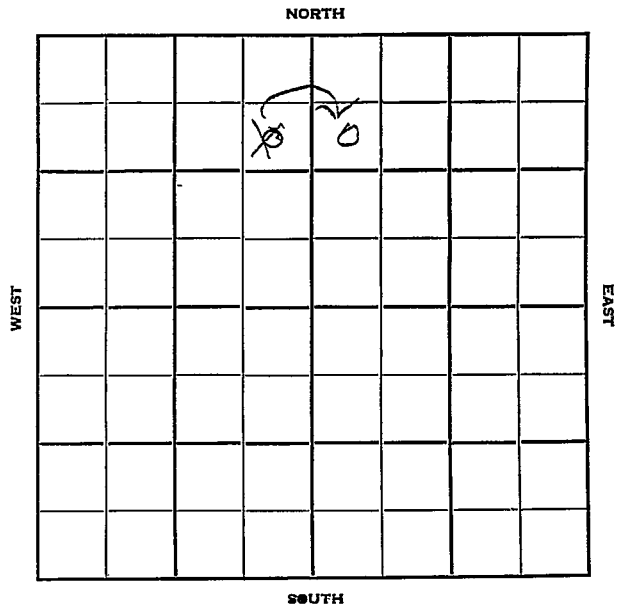

Cowley

KANSAS ✓

Sec. 17 Twp. 34 R. 3E

Well No. #2 M. O. Palmer Farm  
Oquinn Company

Baird Pool Contractor

990 Ft. from N. Line


Ft. from S. Line

330 Ft. from E. Line

330 Ft. from W. Line

~~SE NE NW~~

**SW NW NE**

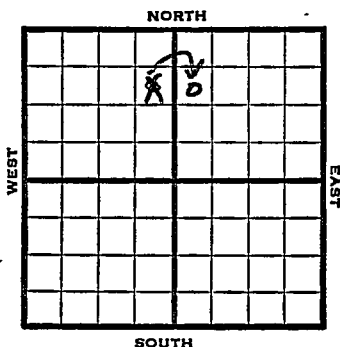

1952

Elev. 1120 REPORT

7/30

Spud 7-24-52  
8" @ 100'  
Drlg. 1799'

9/24

Spud 7-24-52 Oil Well TD 3361  
8" @ 100' Top 1500 Stal 2187  
Layton 2624 KC 2790  
Oswego 3007 Bart 3336  
Miss 3347 TD 3361  
4" @ 3347 S/43 bo 5 hr.  
PB 3335 Sd-frac  
FU 3000' oil 12 hr. Comp. 20 bopd

**COMPLETED**

County Cowley State Kansas

Sec. 17 (Blk. Twp.) 34 (Sur. Rge.) 3E Map No.

Operator Oquinn

Well No. 2 Farm Mc.O. Palmer

Elev. Location SE NE NW

		0			

990 Ft. From N Line NW

330 Ft. From E Line Quarter

Ist. Report JUL 30 1952

Completion \_\_\_\_\_

Remarks \_\_\_\_\_

Spudding Date 7-24-52

Drlg. Data Baird Pool

8" @ 100 drlg. 1799

Map No. \_\_\_\_\_ Sec. 17 Twp. 34 R. 3E

Well No. 2 M. O. Palmer

O'Quinn Company

**CORRECTION** Contractor

SW NW NE

SECTION PLAT

990 Ft. from N. Line

\_\_\_\_\_ Ft. from S. Line

\_\_\_\_\_ Ft. from E. Line

330 Ft. from W. Line

		o	

Cowley County

Location \_\_\_\_\_

Rig up \_\_\_\_\_

Drilling and Remarks:

Reported

SE NE NW

RECORD

Cased \_\_\_\_\_ in., \_\_\_\_\_ ft.

Sand \_\_\_\_\_

Gas \_\_\_\_\_

Oil \_\_\_\_\_

Total Depth \_\_\_\_\_

PRODUCTION

1st 24 hrs. Nat. \_\_\_\_\_

1st 24 hrs. after shot \_\_\_\_\_

Gas \_\_\_\_\_ Cu. Ft.

Dry Hole \_\_\_\_\_

Abandoned \_\_\_\_\_

Date

JUL 30 1959 19

J. G. McGEHEE

Scout

County Cowley State Kansas

Sec. 17 (Blk. 34 (Sur. 3E (Twp. 3E Map No.

Operator O'Quinn

Well No. 2 Farm M. O. Palmer

Elev. 1120 Location SW NW NE


990 Ft. From N Line NE  
 330 Ft. From W Line Quarter

1st. Report

Completion SEP 24 1952

Remarks Baird Pool

Spudding Date 7-24-52

Drlg. Data Oil well TD 3361

8" @ 100 Top. 1500 Stal. 2187

Layton 2624 KC 2790 Oswego 3007

Bart. 3336 Miss. 3347 TD 3361 4" @

3347 S/ 43 bo 5 hr. PB 3335 sd-frac

FU 3000' oil 12 hr. Comp. 20 hpd

J. G. McGEHEE