

Cowley


KANSAS

DX 78-1

Section 17 Township 34 Range 3E

Well No. #2 Warren

Company Stelbar Oil

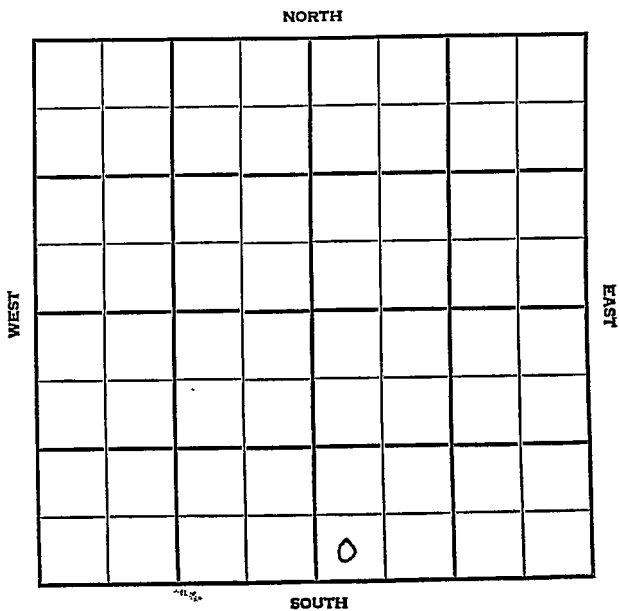

Cowley

KANSAS

SEC	TWP.	R.
17	34	3E

WELL NO. #2 Warren FARM

COMPANY Stelbar Oil

CONTRACTOR Stelbar.


Baird Pool

Ft. from N. Line

330 Ft. from S. Line

Ft. from E. Line

330 Ft. from W. Line

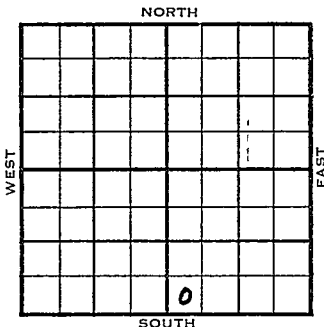

SW SW SE

1955	ELEVATION	REPORT
------	-----------	--------

4/6 M I R

